

Name S. L. & R. G. Smith
 Address ⁷~~13~~ Bowker St., Lexington

Service No. 20 107

Location

Kind of Pipe

Size

Size of Main

~~Repair - Renewal~~ - New Service

Location

Date	Material	Amount	Total	Date	Amount
<i>Comm. 36.42 5-16-32</i>	35' 6" Sewer Pipe @.15	\$5 25		<i>1932 July 8</i>	<i>Cash</i>
	1 1/8" Bend	70			<i>60 00</i>
	5' 4" Iron Pipe @.50	2 50			
	Sulphur & Jute	1 40			
	Trucking	75	\$10 60		
<i>7/8/32</i>	34 Hrs. Labor @.55	18 70			
	3 " " @.60	1 80			
	3 " " @.65	1 95	22 45		
	15% Overhead		3 37		
			36 42		
<i>Aug. 23</i>	<i>Labor Refund from Sewer Receipts</i>		<i>23 58</i>		
			<i>60 00</i>		

*7/8/32 Deposited 60.00
 Refund 23.58
 36.42*

Hadley Press, Inc., Lexington

TOWN OF LEXINGTON—BOARD OF PUBLIC WORKS

SEWER DIVISION

DATE

July 7, 1932

NO.

The undersigned applies for the construction of a particular sewer connecting No. 13 Bowker Dr Street and hereby agrees to comply with the Rules and Regulations governing the construction and use of Particular Sewers, as now or at any future time established by the Board of Selectmen.

Am't. of Estimate \$

60. for complete job


~~Am't. Paid \$~~

48.00 if own dig own trench!
60.00 job

Shirley L Smith
Hetta G. Smith

Owner

Sketch of Service Here

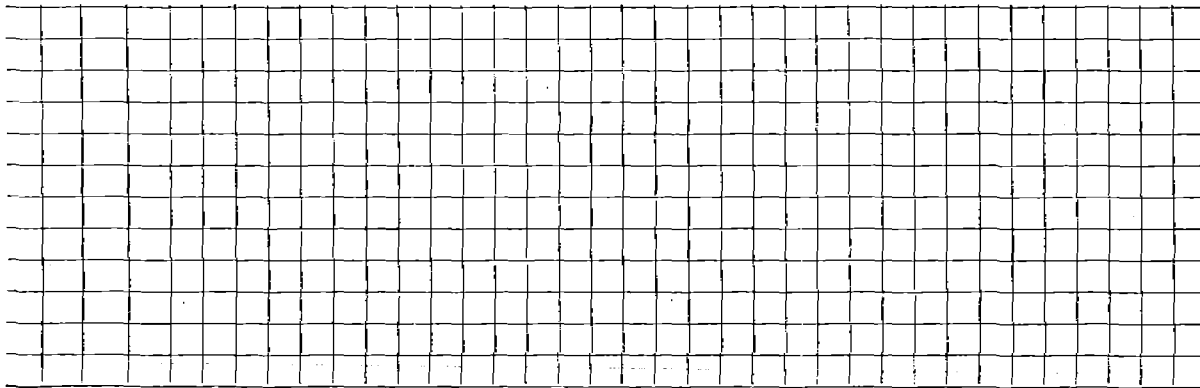

Connection made in _____ Street.

Work completed _____ 19

Remarks: