

Name

Service No.

Address

11 Bowman

Location

Kind of Pipe

Size

Size of Main

Repair—Renewal—New Service

Location

Date

Material

Amount

Total

Date

Amount

9/27/18

6" SDR 35 ~30 ft.

1, 6" PVC 22°  
BEND


1, 4" CLEAN OUT

DATE \_\_\_\_\_

# TOWN OF LEXINGTON — BOARD OF PUBLIC WORKS

## SEWER DIVISION

Sketch of Service Here

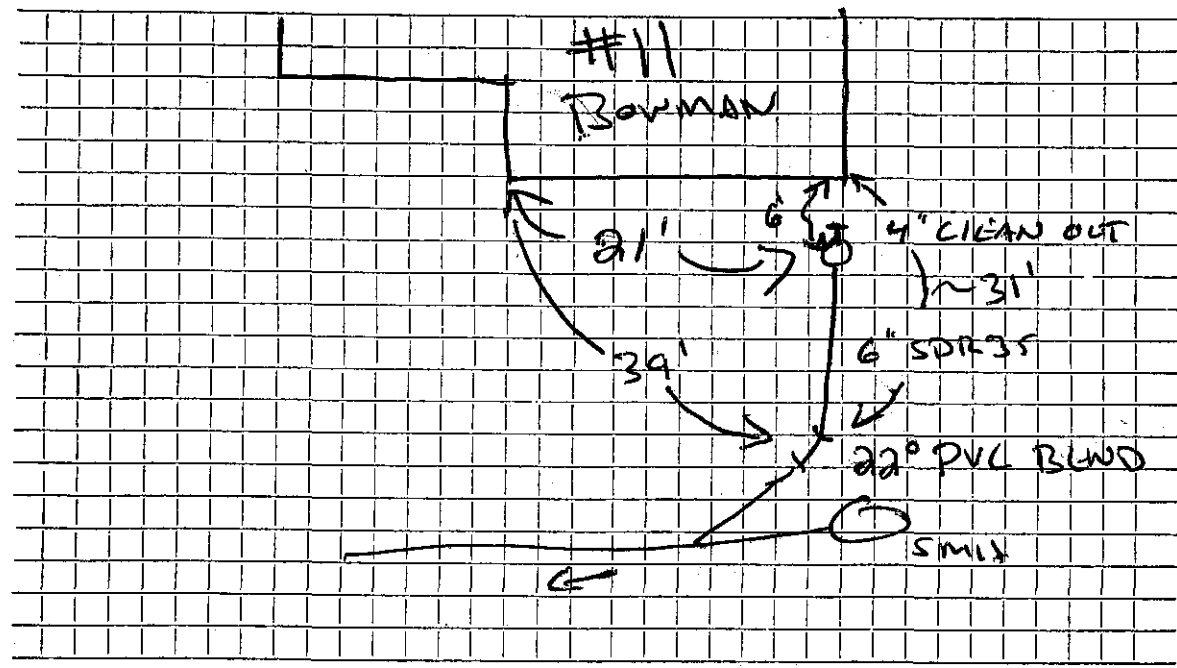

Connection made in ..... Street. Work completed .....

Remarks: .....  
.....  
.....