




DATE 3.10.98

TOWN OF LEXINGTON — BOARD OF PUBLIC WORKS  
SEWER DIVISION

Sketch of Service Here

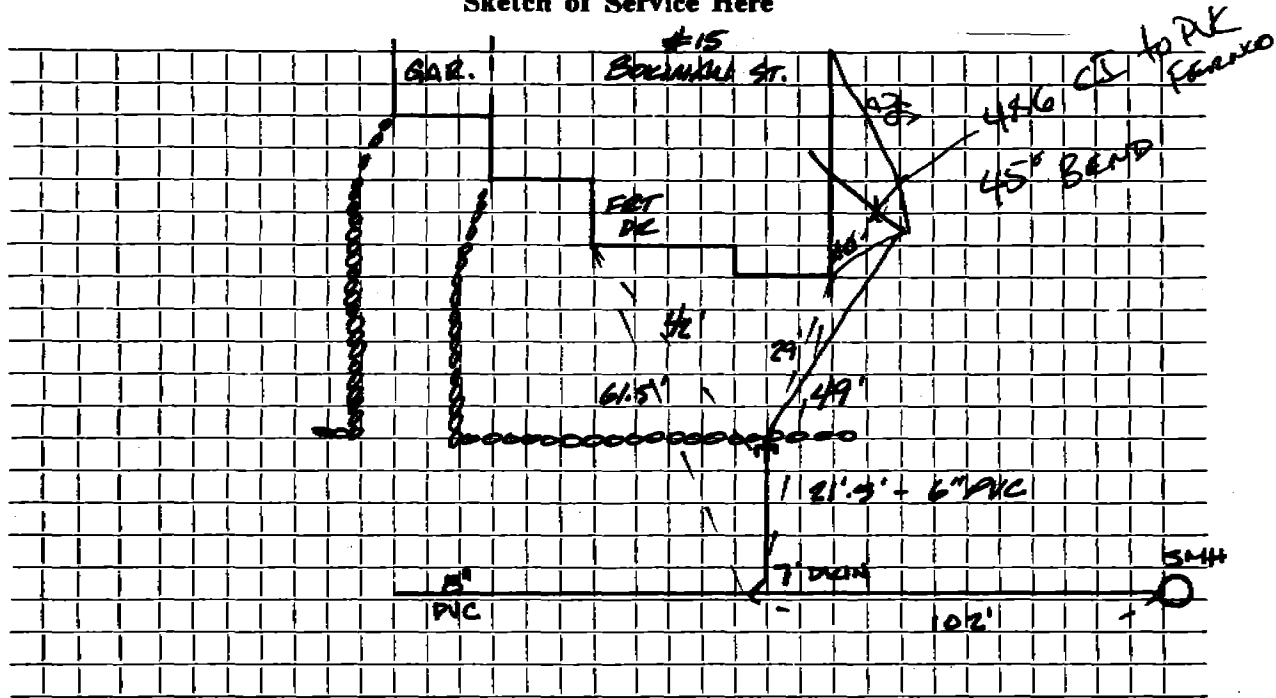

Connection made in ..... BOYMAN ..... Street. Work completed ..... CONTRACT 97-4 .....

Remarks: .....  
.....  
.....