


DATE 3-11-98

TOWN OF LEXINGTON — BOARD OF PUBLIC WORKS
SEWER DIVISION

Sketch of Service Here

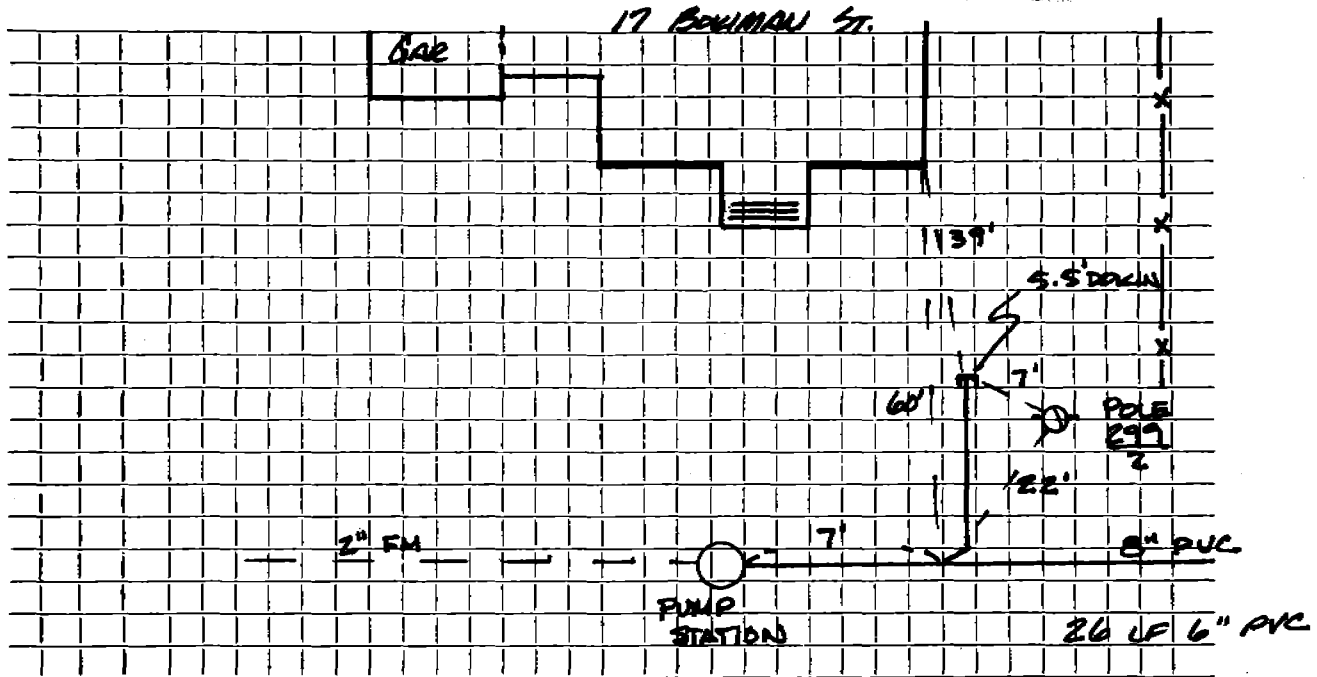

Connection made in BOWMAN Street. Work completed CONTRACT 97-4

Remarks: