

Name Thomas Randy Thomas Randy

**Service No.** 27

**Address** 10 BOWSER RD.

## **Location**

**Kind of Pipe** *A.C.*

**Size** 6"

**Size of Main** 10"

~~Reserve Removal~~—New Service Parella & Sons #4585

**Location** SEP 5 1986


DATE \_\_\_\_\_

TOWN OF LEXINGTON — BOARD OF PUBLIC WORKS

SEWER DIVISION

Sketch of Service Here

10

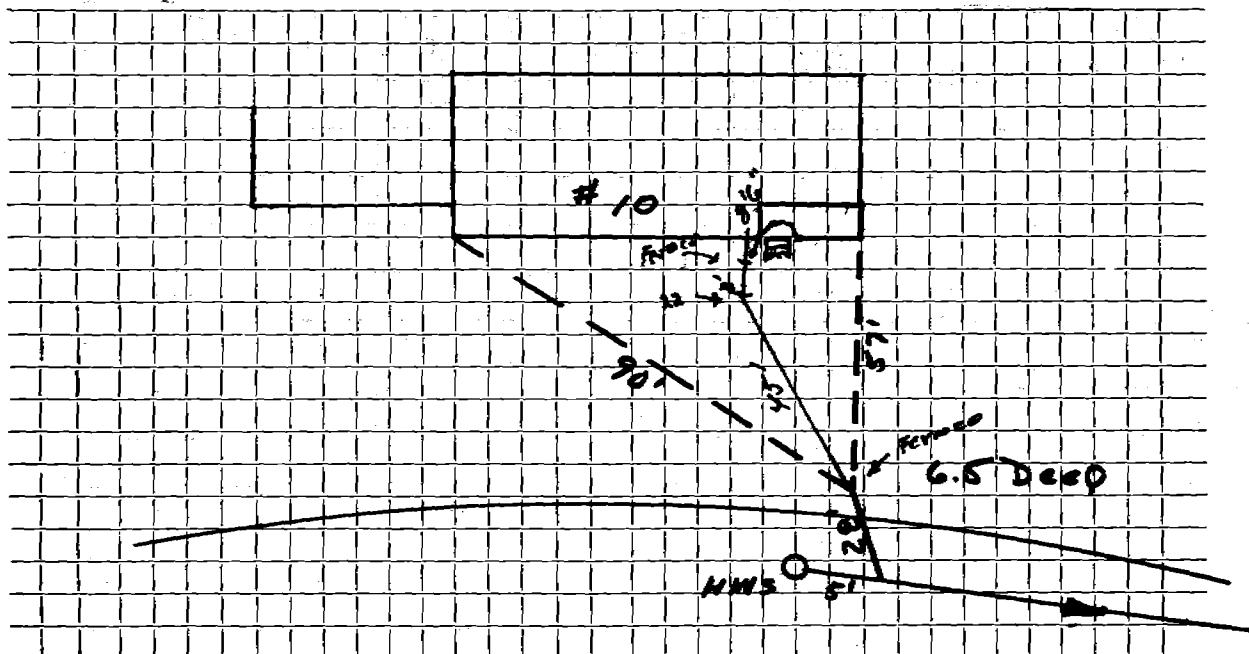

Connection made in ..... Street. Work completed .....

Remarks: .....

.....