

Name Richard Foley

Service No. 228

Address 3 Bowser Road

Lot #22 Sta. 7+87 El. 180.65

Location

Kind of Pipe

Size

Size of Main

Repair—Renewal—New Service WO# 7781


Location Comm 6-3-63

Date		Material	Amount	Total	Date		Amount
6-21-62		Labor	14.33		12-19-63	Deposit	150 00
		10% O.H.	1.43	15.76	6-3-63	Retard	55.58
	26'	6" Transite pipe @.78		20.28			94 42
		BILL WHEN CONNECTED		36.04			
4-18-63		Labor	12.34				
		10% O.H.	1.23	13.57	4-25-67	Respond + measure	
	46'	6" Transite pipe @.82		37.72		use my keys	
	1	11 1/4° Transite Bend		4.09	6-12-02	Problem seems to	
	1	hr. Trucking @3.00		3.00		be at connection to	
				94.42		MH - Respond	
					Apply 13.09 to WO# 181		

DATE _____

TOWN OF LEXINGTON — BOARD OF PUBLIC WORKS
SEWER DIVISION

Sketch of Service Here **3**

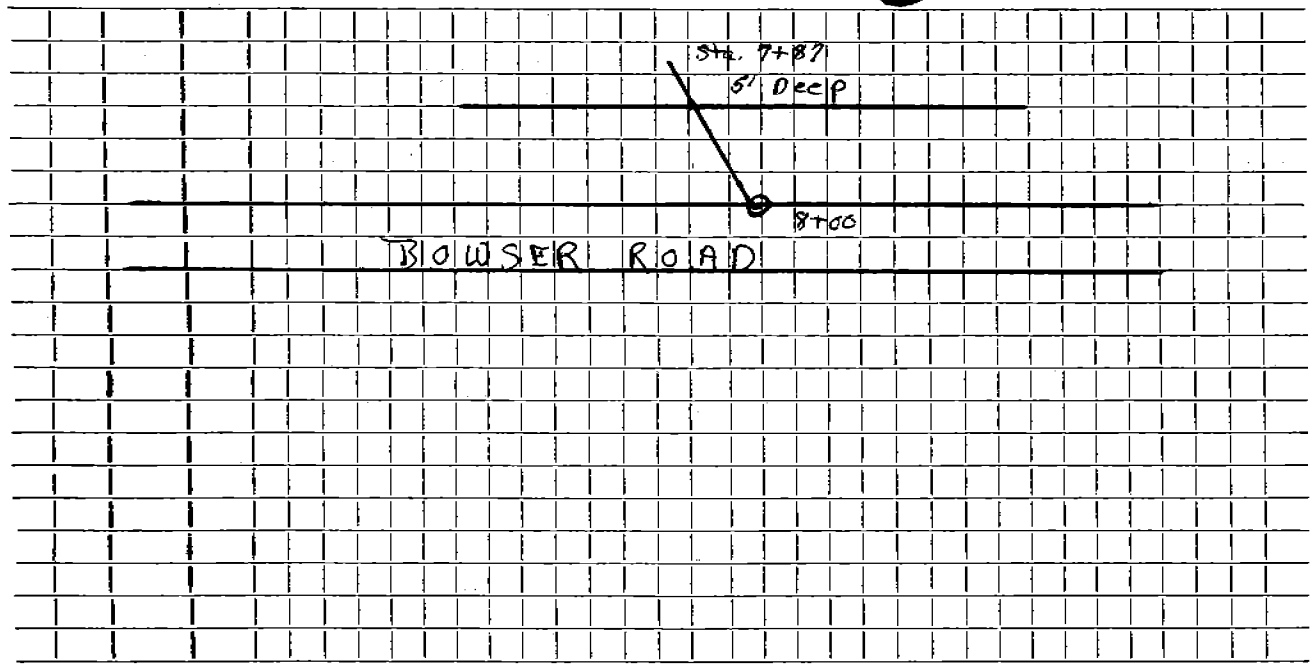

Connection made in Street. Work completed

Remarks:
.....
.....