

Name Moore Realty Trust

Service No. 179

Address 5 Bowser Road

Lot #21 Sta. 6+36 EL. 181.58

Location

Kind of Pipe

Size

Size of Main

~~Repair~~ ~~Rebuild~~ New Service W.O. # 2204

Location Comm 1-14-63


Date	Material	Amount	Total	Date	Amount
6-22-62	Labor	21.50		11-1-62	Deposit 150.00
	10% O.H.	2.15	23.65	1-14-63	* Refund 44.89
	39' 6" Transite pipe @.78		<u>30.42</u>		10.51
	BILL WHEN CONNECTED		54.07		
11-14-62	Labor	16.11			
	10% O.H.	1.61	17.72		
	35' 6" Transite pipe @82		28.70		
	1 6" Duplex Adapter		1.62		
	1 Hr. Trucking @3.00		<u>3.00</u>		
			105.11		
				* Applied to W.H.C. # 154	11.58
				* " " " # 171	10.79

DATE _____

TOWN OF LEXINGTON — BOARD OF PUBLIC WORKS
SEWER DIVISION

Sketch of Service Here

5

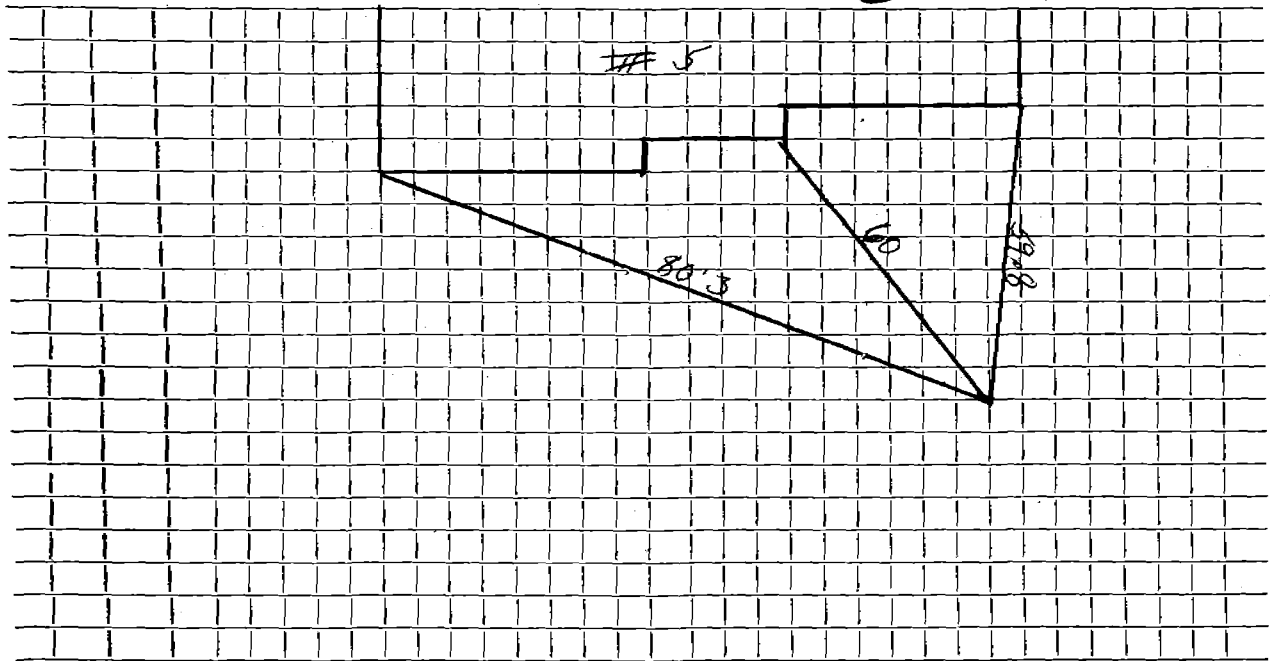

Connection made in Street. Work completed

Remarks:
.....
.....