

Name **Moore Realty Trust**

Service No. **1**

Address **6 Bowser Road**

Lot #32 Sta. 5+78 El. 181.78

Location

Kind of Pipe

Size

Size of Main

~~KOPIN-88507A~~ - New Service

WO# 8460

Location

MAR 23 1964


Date	Material	Amount	Total	Date	Amount
6-23-62	Labor	14.33		1-3-64	100.00
	10% O.H.	1.43	15.76	3-23-64	1.01
	26' 6" Transite pipe @.78		20.28		101.01
	1 11 1/2" Transite Bend		4.09		
	BILL WHEN CONNECTED		40.13		
1-6-64	Labor	22.80			
	10% O.H.	2.28	25.08		
	40' 6" Transite Pipe @.82		32.80		
	1 Hr. Trucking @3.00		3.00		
			101.01		

DATE _____

TOWN OF LEXINGTON — BOARD OF PUBLIC WORKS
SEWER DIVISION

Sketch of Service Here

6

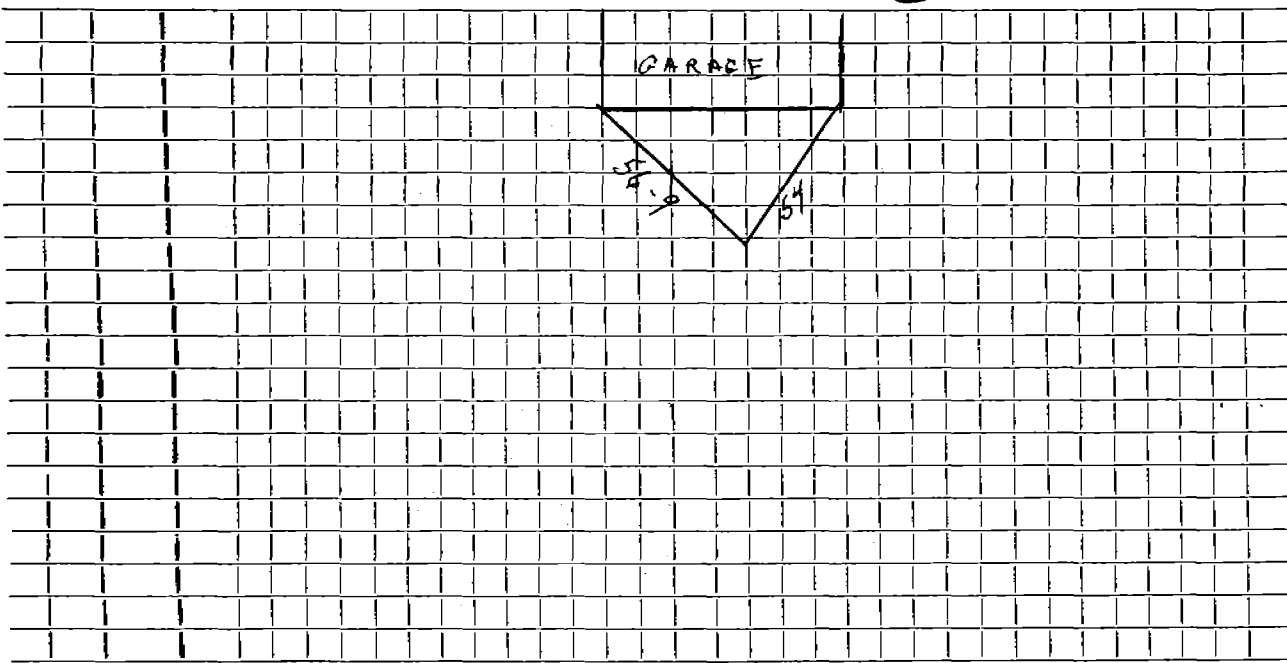

Connection made in Street. Work completed

Remarks:
.....
.....