

Name Robert Johnson

Service No. 116

Address 9 Bowser Road

Location

Kind of Pipe

Size

Size of Main

~~Repair/Replace~~ New Service W.O. #8187

Location

Comm 2-10-64


Date	Material	Amount	Total	Date		Amount
9/23/63	Labor	75 17		9-9-63	Deposit	400 00
	10% O.H.	7 52	82 69	2-10-64	Retard	160 27
	110' 6" Transite Pipe @ .82		90 20			239 73
	1 11 1/4" Transite Bend		4 09			
	7 1/2 Ton Bank Gravel @ 1.10		8 25			
	5 Hrs. Town Shovel @ 6.50		32 50			
	2 Hrs. Trucking @ 3.00		6 00			
	16 X 3 Patch		16 00			
			239 73			

DATE _____

TOWN OF LEXINGTON — BOARD OF PUBLIC WORKS
SEWER DIVISION

Sketch of Service Here

9

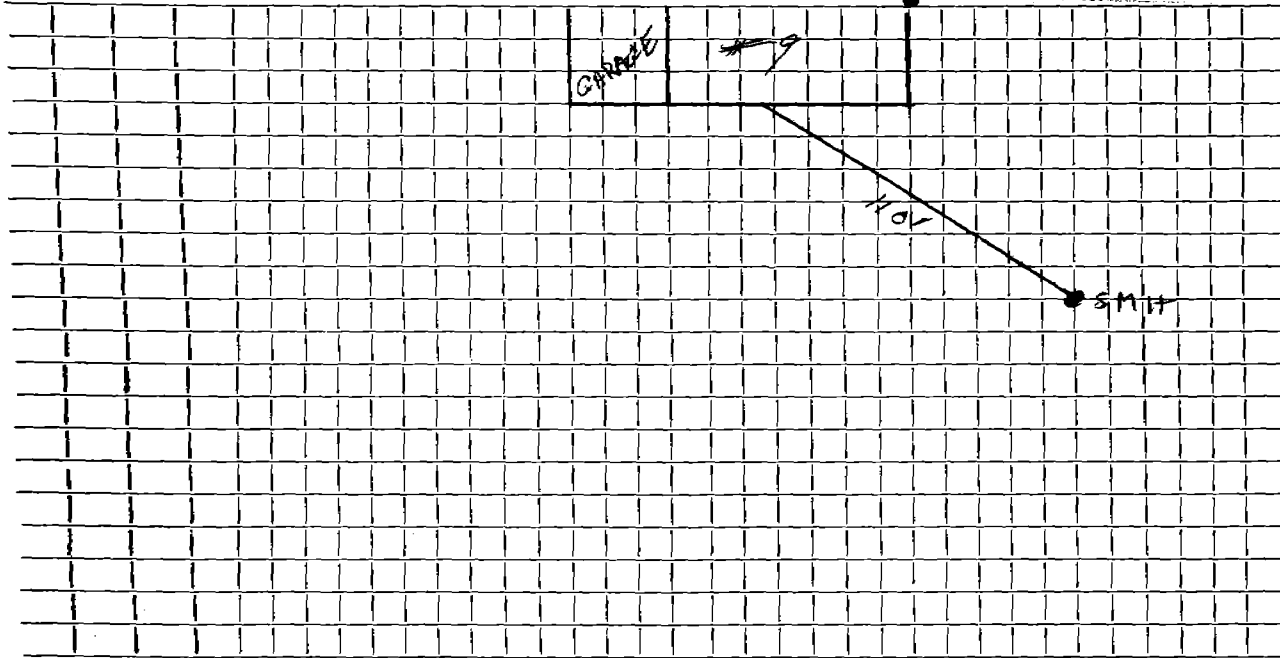

Connection made in Street. Work completed

Remarks:
.....
.....