




DATE \_\_\_\_\_

**TOWN OF LEXINGTON — BOARD OF PUBLIC WORKS**  
**SEWER DIVISION**

Sketch of Service Here

LOT 16

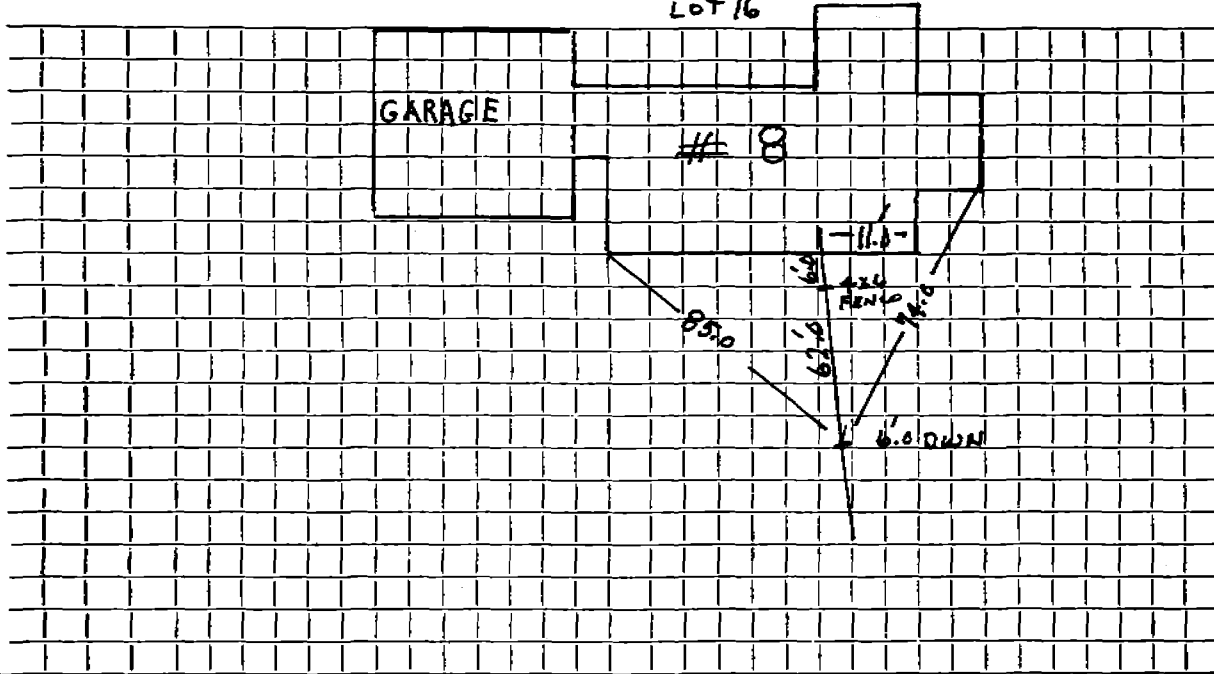

Connection made in Boxwood Street. Work completed .....

Remarks: .....  
.....  
.....



