

Name Ruth M. Haskell

Service No. 26 113

Address 1 Brandon St., Lexington

Location Same

Kind of Pipe

Size

Size of Main

~~Repair-Renewal~~—New Service

Location

Date	Material	Amount	Total	Date	Amount
10/15/35	34 hrs. labor @ 55¢	\$18 70		10-11-35	Deposited 10 00
Com. # 40-53 12-30-35 to Russell	9 " " @ 60¢	5 40		June 9, 1936	Abated 27 53
	10% Ovhd. on labor		24 10	Aug 22 1936	Bal. 3 00
62'	6" Sewer Pipe @ 16¢	9 92			40 53
	Sulphur & Jute	3 10			
	Trucking	1 00	14 02		
			40 53		
	Labor			Billed 12-31-35	
				John 6-10-36	
				Gordon 5-20-36	

Hadley Press, Inc., Lexington

TOWN OF LEXINGTON—BOARD OF PUBLIC WORKS

SEWER DIVISION

DATE 12/11/35

NO. 1 Brandon St.


The undersigned applies for the construction of a particular sewer connecting No. 1 Brandon St. Street and hereby agrees to comply with the Rules and Regulations governing the construction and use of Particular Sewers, as now or at any future time established by the Board of Selectmen.

Am't. of Estimate \$ 13.00

Am't. Paid \$ 10.00

Ruth M. Haskell Owner

Sketch of Service Here

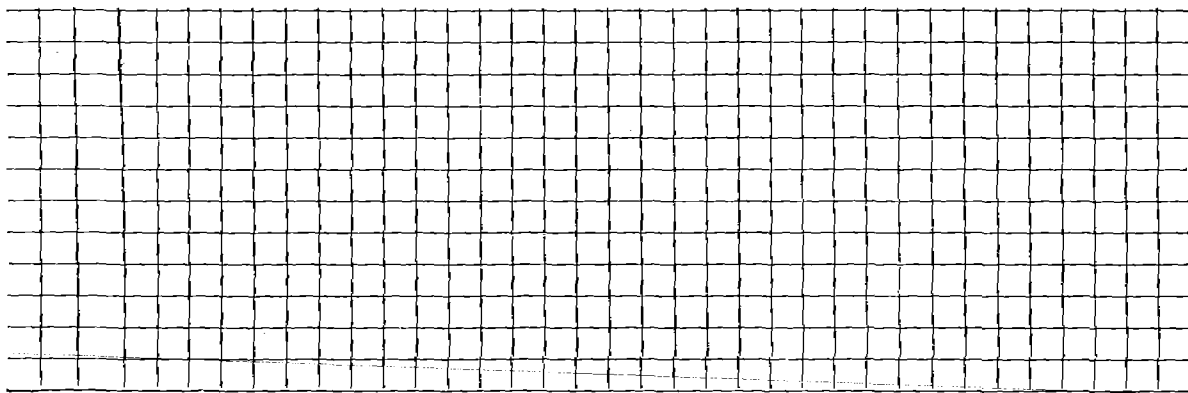

Connection made in _____ Street.

Work completed _____ 19

Remarks: