

Name John B. Hughes

Service No. 17

Address 12 Brandon Street

Lexington, Mass.

Location

Kind of Pipe

Size

Size of **Main**

~~Repair-Renewal~~ **New Service**

Location

Date		Material	Amount.		Total		Date		Amount	
Aug. 26,	'48	Labor	27	08	27	08	Aug 17 48	Reported	85	00
"	27	"	28	33	28	33	Dec 31 48	Refunded	3	65
		10% Overhead			5	54			81	35
		40'-6" Sewer Pipe @ .26			10	40				
		Joint Compound			1	50				
		1 hr. Littlefield Shovel			7	00				
		22 hrs. Trucking			1	50				
					81	35	3-23-64	S.B.	18	50
							4-23-64	ROOTS		
		Labor					9-14-66	ROOTS		
							12-16-91	Roots 5' from house		

TOWN OF LEXINGTON—DEPT. OF PUBLIC WORKS  
SEWER DIVISION

DATE .....

NO. ....


The undersigned applies for the construction of a particular sewer connecting No. ....  
Street and hereby agrees to comply with the Rules and Regulations governing the construction and use of Particular  
Sewers, as now or at any future time established by the Board of Selectmen.

Am't of estimate \$ . . . . .

Am't Paid \$ . . . . .

..... Owner

Sketch of Service Here **12**

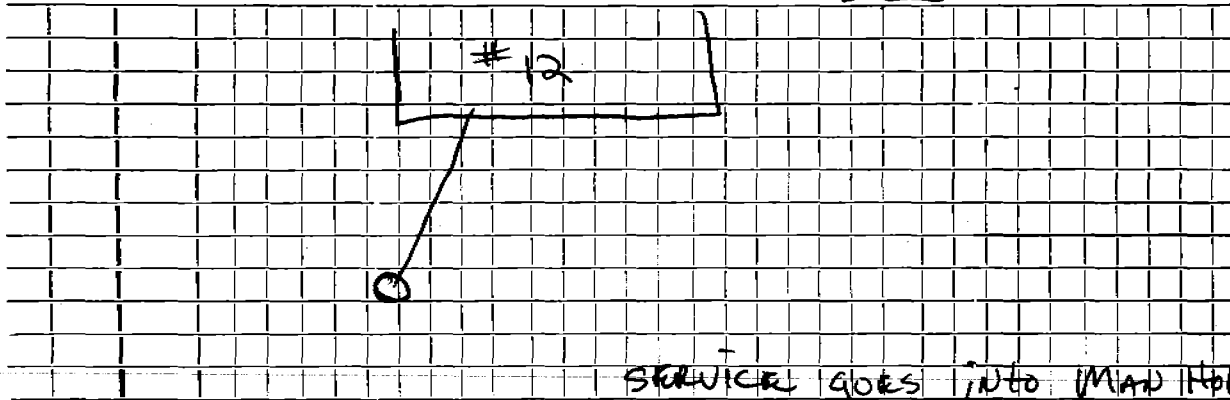

Connection made in ..... Street.

Work completed ..... 19..

Remarks: