

Name Frank G. Poitrast
 Address Wilmington, Mass.

Service No. 9 117

Location cor. Fottler Avenue & Brandon St.,
 #15 Brandon St.,

Kind of Pipe Size Size of Main
 Repair—Renewal—New Service Location

Date	Material	Amount	Total	Date	Amount
1938					
5/12/38	47hrs. @ 50¢	25 85		May 3, 1938 Deposited	80 00
<i>from 7-5-38</i>	31½ @ 60¢	<u>18 90</u>	44 75		
	10% Overhead		4 48		
	40' 6" Sewer Pipe @ 20¢		8 00		
	5' 4" Soil Pipe		2 50		
	Joint Compound		2 40		
	4 hrs. trucking @ 75¢		3 00		
	3½ hrs. Compressor @ 3.00		10 50		
	1 6" Bend		65		
	1 6 x 4 Reducer		<u>1 00</u>		
			<u>77 28</u>		
	Flat Rate \$80.00		80 00		
	Labor				
				2-22-67	ROOTS

Hadley Press, Inc., Lexington

TOWN OF LEXINGTON—BOARD OF PUBLIC WORKS

SEWER DIVISION

DATE April 5, 1938

NO. Cor Fattler
Lots 128 & 129 + Brandon
(15-Brandon)


The undersigned applies for the construction of a particular sewer connecting No. Lots 128 & 129 + Brandon Street and hereby agrees to comply with the Rules and Regulations governing the construction and use of Particular Sewers, as now or at any future time established by the Board of Selectmen.

Am't. of Estimate \$ 800.00

Am't. Paid \$ _____

Frank G. Poitrost Owner
for Marian M. Poitrost

Sketch of Service Here

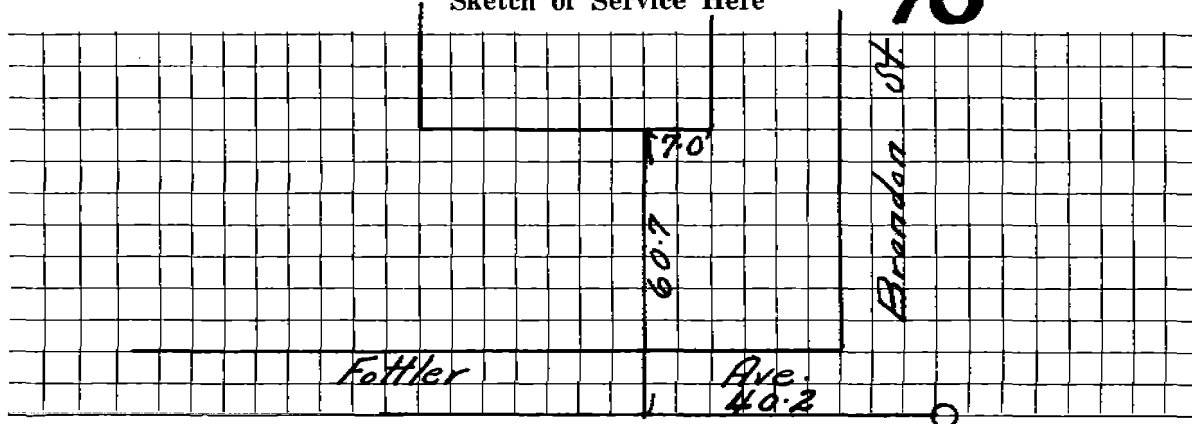

Connection made in _____ Street.

Work completed _____ 19

Remarks: