

Name Benjamin Gott

Service No. 63

Address 30 Brandon Street

Lexington

Location

Kind of Pipe

Size

Size of Main

~~XXXXXXXXXX~~ New Service

COM. 7-28-52

Location

Date	Material	Amount	Total	Date	Amount
6/3/52	Labor	44 60		5-1-52	Deposited 125 00
6/4/52	"	8 92	53 52	7-28-52	Refunded - - - - - 19 67
	10% overhead		5 35		" x credited 3 25
	54' - 6" sewer pipe @ .342		18 47		to S. H. C. #43 202 08
	joint compound		3 24		bal. due on 38 Brandon St
	4 hrs. town shovel @ 5.00		20 00		
	2 hrs. trucking		1 50		
			<u>102 08</u>		
	Labor				

TOWN OF LEXINGTON—DEPT. OF PUBLIC WORKS
SEWER DIVISION

DATE.....

NO.


The undersigned applies for the construction of a particular sewer connecting No.....
Street and hereby agrees to comply with the Rules and Regulations governing the construction and use of Particular
Sewers, as now or at any future time established by the Board of Selectmen.

Am't of estimate \$.....

Am't Paid \$.....

..... Owner

Sketch of Service Here

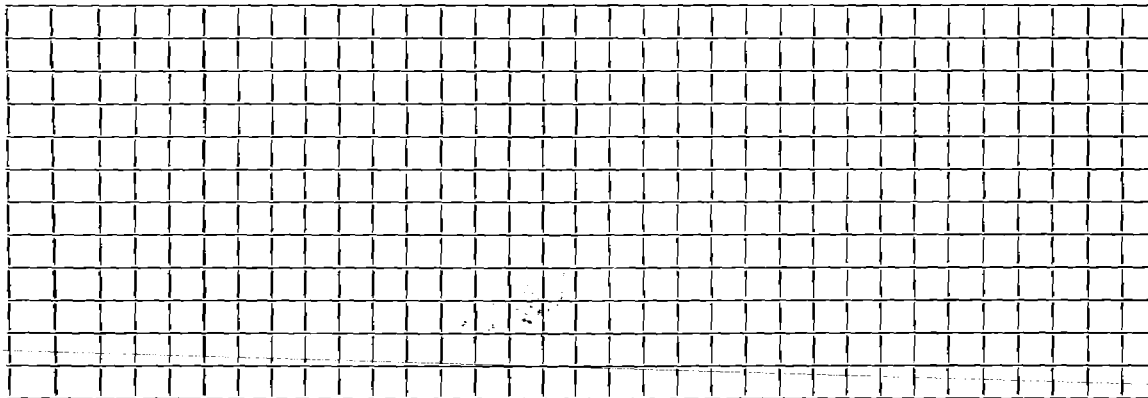

Connection made in Street.

Work completed.....19..

Remarks: