

Name Marshall A. Boyler

Service No. 7 118

Address 33 Brandon Street, Lexington

Location

Kind of Pipe

Size

Size of Main

Repairs—Renewal—New Service

Location

Date	Material	Amount	Total	Date	Amount
Apr. 10, 1942 <i>Com 7/13/42</i>	37½ hrs. @ 60¢	22 50		April 3, 1942	90.00
	25 " @ 65¢	16 25		April 23, 1942	18.33
	12½ " @ 75¢	9 38	48 13		<u>71.67</u>
	10% Overhead		4 81		
	16' 6" Sewer Pipe @ 16¢	2 56	2 56		
	12' 6" Cast Iron Pipe @ 1.01	12 12	12 12		
	1 6" 1/8 Bend		60		
	Jointing compound		1 20		
	Trucking, 3 hrs. @ 75¢		2 25		
			<u>\$71 67</u>		
	Labor				

Hadley Press, Inc., Lexington

TOWN OF LEXINGTON—BOARD OF PUBLIC WORKS

SEWER DIVISION

DATE 4/2/42

NO. \_\_\_\_\_

The undersigned applies for the construction of a particular sewer connecting No. 33 Brandon Street and hereby agrees to comply with the Rules and Regulations governing the construction and use of Particular Sewers, as now or at any future time established by the Board of Selectmen.


Am't. of Estimate \$ 90.00

Am't. Paid \$ 90.00

*Marshall A. Bayler* owner

Sketch of Service Here

**33**

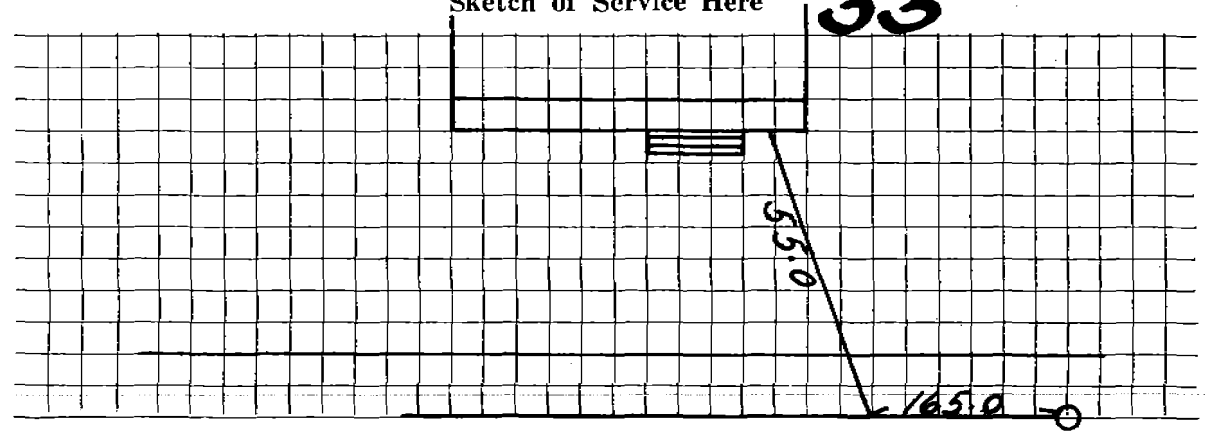

Connection made in \_\_\_\_\_ Street. Work completed \_\_\_\_\_ 19

Remarks: