

Name Vadeboncoeur, Dorothy C.

Service No. 2 119

Address 35 Brandon Street, Lexington

Location Same

Kind of Pipe

Size

Size of Main

~~Repair - Renewal~~ - New Service

Location

Date	Material	Amount	Total	Date	Amount
1936					
Jan. 10	30 hrs. labor @ 60¢	18 00		Jan 7, 1936 Deposited	50 00
Com. 5-12-36 to Russell 43	" " @ 55¢	23 65	41 65		
	10% Ovhd. on labor		4 17		
	28' 6" Sewer Pipe @ 16¢		4 48		
	Sulphur & Jute Trucking		1 10 <u>1 00</u>		
			52 10		
	Say: \$50.00				
	Labor				

Hadley Press, Inc., Lexington

TOWN OF LEXINGTON—BOARD OF PUBLIC WORKS

SEWER DIVISION

DATE Jan. 8 1936

NO. _____

The undersigned applies for the construction of a particular sewer connecting No. 35 Brandon St Street and hereby agrees to comply with the Rules and Regulations governing the construction and use of Particular Sewers, as now or at any future time established by the Board of Selectmen.


Am't. of Estimate \$ 50.00

Am't. Paid \$ 50.00

Harold C. Vadeboncoeur Owner

Sketch of Service Here

35

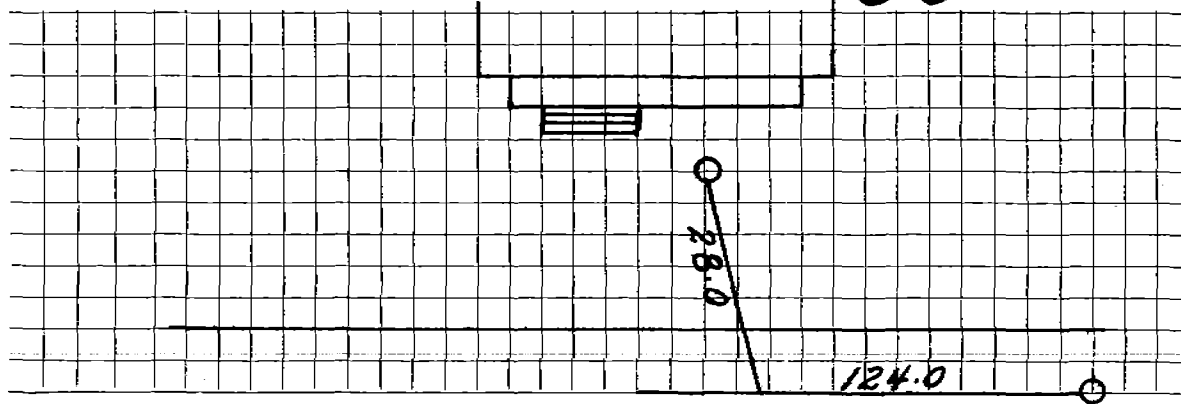

Connection made in _____ Street.

Work completed _____ 19

Remarks: