

Name Benjamin Gott

Service No. 63

Address 36 Brandon Street

Lexington

Location

Kind of Pipe

Size

Size of Main

~~Repair~~ ~~Renewal~~ ~~New Service~~

COM. 7-28-52

Location

| Date | Material | Amount | Total | Date | Amount |
|--------|----------------------------|--------|--------|---------|------------------|
| 6/2/52 | Labor | 65 42 | | 5-1-52 | Deposited 125 00 |
| | 10% overhead | 6 54 | 71 96 | 7-28-52 | Refunded (10 64) |
| | 52' - 6" sewer pipe @ .342 | | 17 78 | | 114 36 |
| | joint compound | | 3 12 | | |
| | 4 hrs. town shovel @ 5.00 | | 20 00 | | |
| | 2 hrs. trucking | | 1 50 | | |
| | | | 114 36 | | |
| | Labor | | | | |

TOWN OF LEXINGTON—DEPT. OF PUBLIC WORKS
SEWER DIVISION

DATE.....

NO.


The undersigned applies for the construction of a particular sewer connecting No.....
Street and hereby agrees to comply with the Rules and Regulations governing the construction and use of Particular
Sewers, as now or at any future time established by the Board of Selectmen.

Am't of estimate \$.....

Am't Paid \$.....

..... Owner

Sketch of Service Here

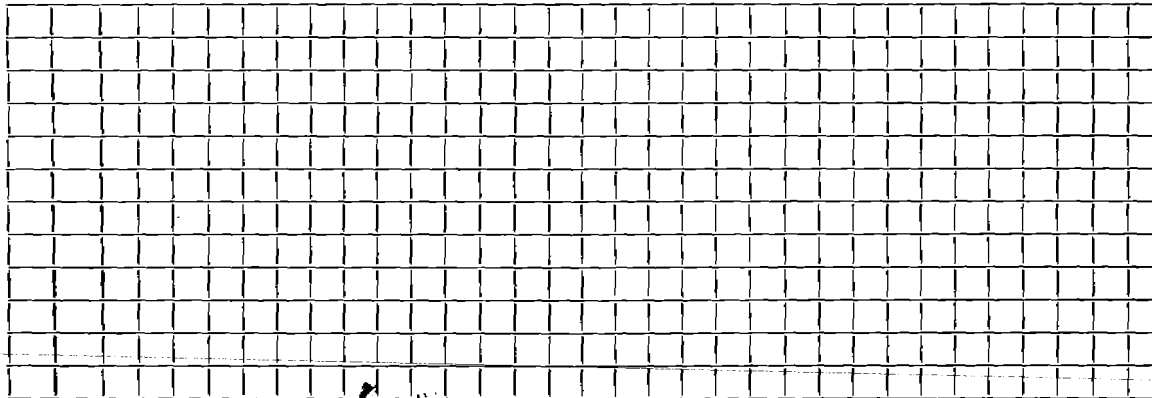

Connection made in Street.

Work completed 19..

Remarks: