

Name John Gilbert

Service No. 13

Address 37 Brandon St.

Location

Kind of Pipe

Size

Size of Main

~~REPLACEMENT~~ New Service W.O. # 6202 Kirkland #1373

Location MAY 27 1969

Date	Material	Amount	Total	Date	Amount
5/5/69	Labor	59 82		4-24-69	240 00
	10% O.H.	5 98	65 80	5-27-69	127 39
	20'- Transitepipe .88		17 60		112 61
	1- 12" Nipple		1 21	5/5/69	
	1- 6" "		91		
	1- 90o Elbow		4 09		
	1- 8x6 Saddle		5 50		
	1- Hr. trucking		3 00		
	1- " "		1 50		
	2- " shovel 6.50		13 00		
			112 61		
6-10-69	16' 4" Transite pipe				

*Deposit*  
*Retard*


NO CHARGE

Labor

DATE \_\_\_\_\_

TOWN OF LEXINGTON — BOARD OF PUBLIC WORKS  
SEWER DIVISION

Sketch of Service Here **37**

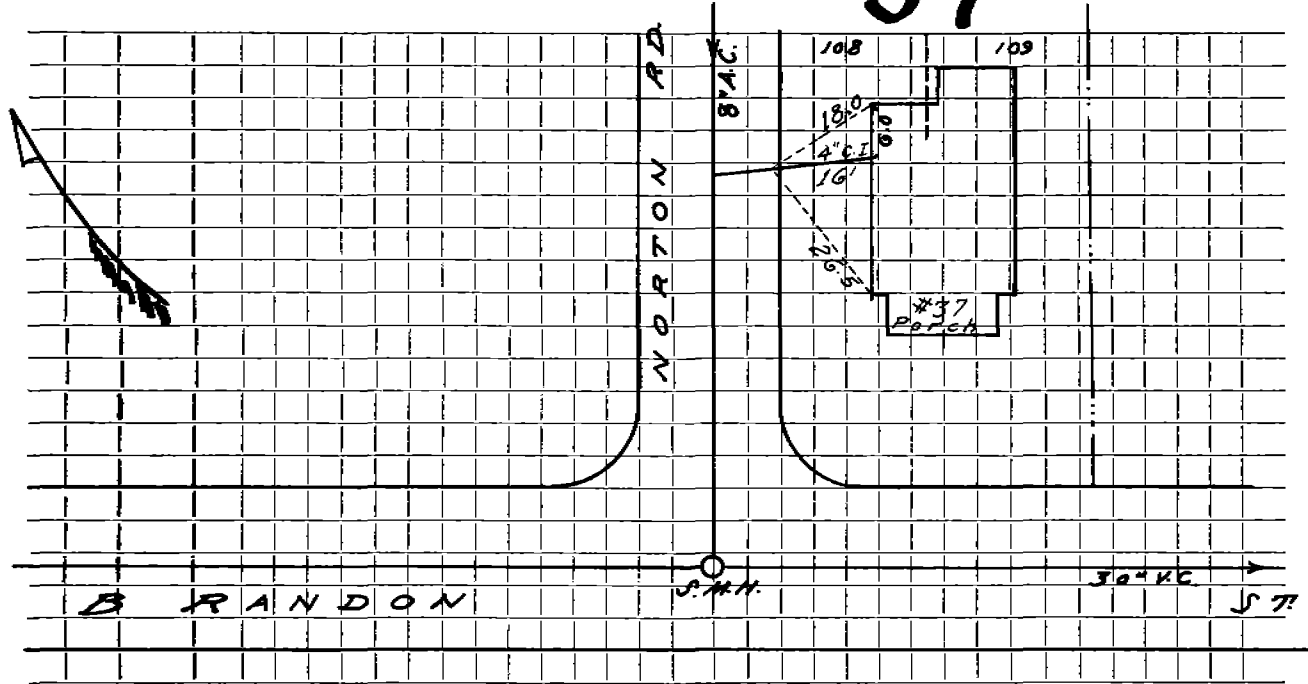

Connection made in ..... Street. Work completed .....

Remarks: .....  
.....  
.....