


DATE _____

TOWN OF LEXINGTON — BOARD OF PUBLIC WORKS
SEWER DIVISION

Sketch of Service Here **4**

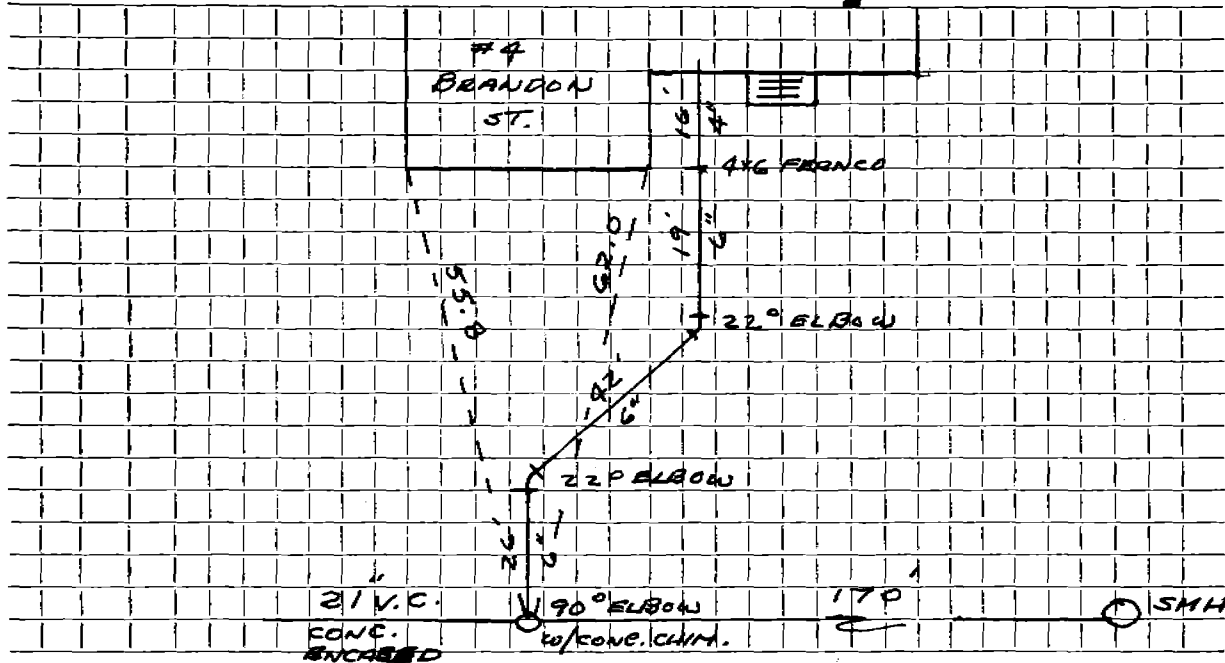

Connection made in BRANDON Street. Work completed

Remarks: KIRKLAND & SHAW Original Service 8-15-39