

Name Margaret Kearns Service No. 83

Address 42 Brandon Street

Location

Kind of Pipe Size Size of Main

~~Repair~~ ~~Rework~~ New Service com. 8-15-55 / PERMIT 0937 - CRESCENT Location

Date	Material	Amount	Total	Date	Amount
6/27/55	Labor	98 12		5-12-55 Deposited	175 00
	10% Overhead	9 81	107 93	8-15-55 Refunded	(24 29)
	56'-6" Sewer Pipe @.32		17 92		150 71
	Joint Compound		3 36		
	4 hrs. Town Shovel @ 5.00		20 00		
	2 hrs. Trucking @.75		1 50		
			150 71		
4/22/1997	26'-6" ϕ PVC				
	1 FERNCO				
	1-22° BEND				
	Labor			4/13/73	Roots

TOWN OF LEXINGTON—DEPT. OF PUBLIC WORKS

SEWER DIVISION

DATE APRIL 22, 1997.....


NO.

The undersigned applies for the construction of a particular sewer connecting No. Street and hereby agrees to comply with the Rules and Regulations governing the construction and use of Particular Sewers, as now or at any future time established by the Board of Selectmen.

Am't of estimate \$.

Am't Paid \$.

.. BARBARA CORCORAN..... Owner

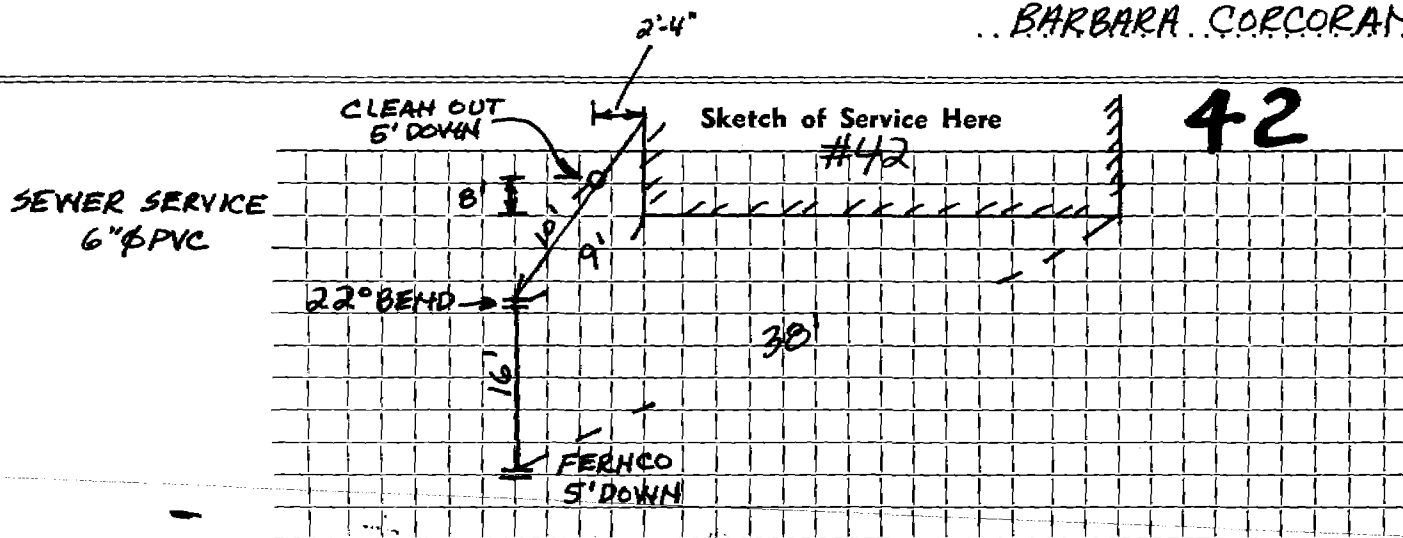

Connection made in BRANDON STREET..... Street.

Work completed APRIL 22..... 1997

Remarks:

BOOK 97-1

J.W.