

Name William Jack

Service No. 22 1036

Address 47 Brandon Street

Lexington, Mass.

Location 47 Brandon Street

Kind of Pipe

Size

Size of Main

~~Repair~~ ~~Renewal~~ New Service

Con 12-2-46

Location

Date	Material	Amount	Total	Date	Amount
Sept. 19, '46	Labor	39 13		Sept. 14, '46	75 00
20, '46	"	38 97	78 10	Jan 30 '46	26 19
	10% Overhead		7 81		101 19
	38' - 6" Sewer Pipe @.269		10 22		
	1 - 6" Elbow		1 28		
	Trucking 2 hrs. @.75		1 50		
11-8-69	Renewal		101 19		
	13' 6" Transite				
	Labor				
				10-25-66	Roots
				10/6/68	Roots

TOWN OF LEXINGTON—DEPT. OF PUBLIC WORKS
SEWER DIVISION

DATE


NO.

The undersigned applies for the construction of a particular sewer connecting No.
Street and hereby agrees to comply with the Rules and Regulations governing the construction and use of Particular
Sewers, as now or at any future time established by the Board of Selectmen.

Am't of estimate \$.....

Am't Paid \$.....

..... Owner

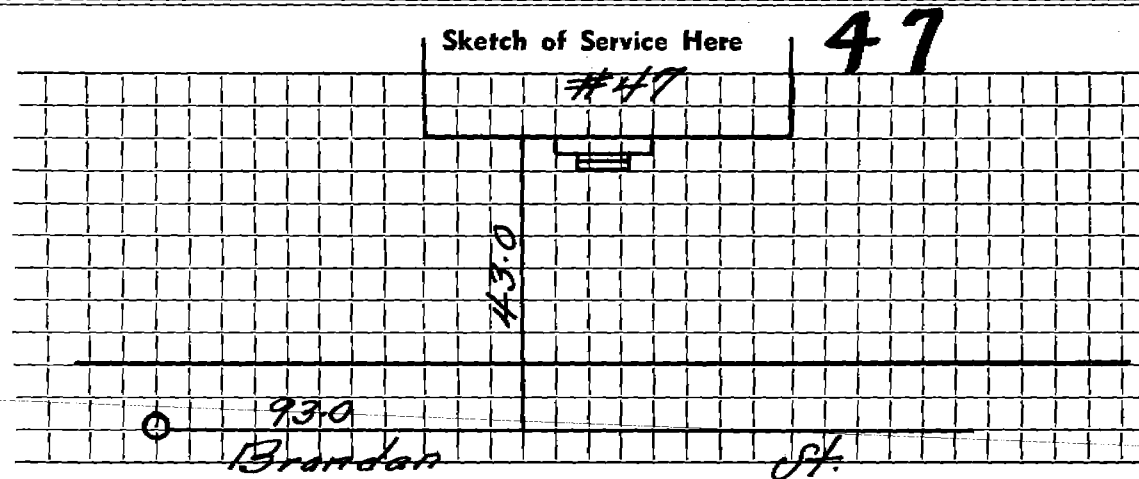

Connection made in Street.

Work completed 19..

Remarks: