

Name Chester R. Banks  
 Address 15 Lorne Road, Arlington, Mass.

Service No. 2 116

Location 8 Brandon Street

Kind of Pipe Size Size of Main  
 Repair—Renewal—New Service Location

Date	Material	Amount	Total	Date	Amount
1939					
April 4,	42 hrs. @ 55¢	23 10		March 30, 1939	30 00
<i>Jan 5-11-39</i>	8 " @ 60¢	4 80	27 90	<i>Deposit</i>	
	10% Overhead		2 79		
	38' 6" Sewer Pipe @ 20¢		7 60		
	1 6" 1/8 Bend		65		
	Jointing Compound		2 28		
	Trucking- 2 hrs. @ 75¢		1 50		
			<u>\$42 72</u>		
	( Charge Flat Rate: \$30.00.)				
	Labor				

Hadley Press, Inc., Lexington

TOWN OF LEXINGTON—BOARD OF PUBLIC WORKS

SEWER DIVISION

DATE March 30, 1939.

NO. \_\_\_\_\_


The undersigned applies for the construction of a particular sewer connecting No. #1 Brandon St. Street and hereby agrees to comply with the Rules and Regulations governing the construction and use of Particular Sewers, as now or at any future time established by the Board of Selectmen.

Am't. of Estimate \$ 30-

Am't. Paid \$ \_\_\_\_\_

Christie B. Cook  
Owner

Sketch of Service Here

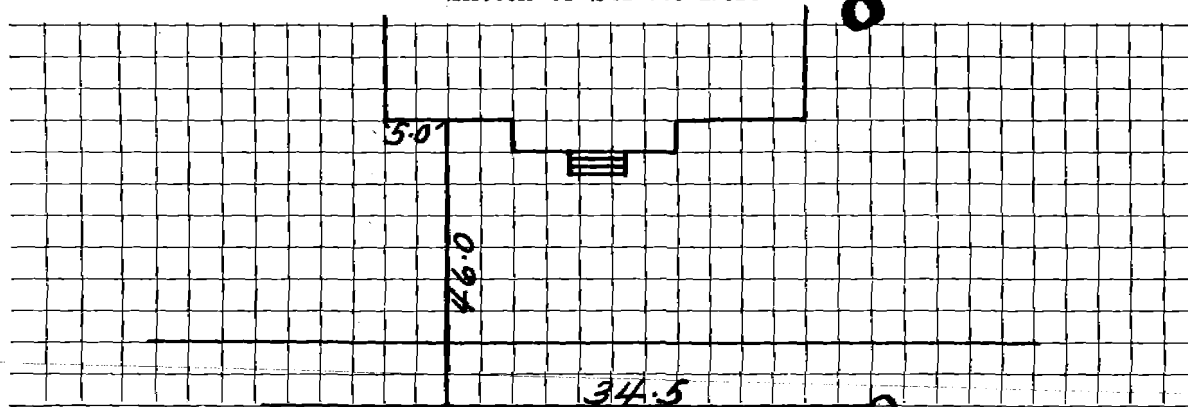

Connection made in \_\_\_\_\_ Street.

Work completed \_\_\_\_\_ 19

Remarks: