

Name **Martin Goldman**

Service No. **198**

Address **11 Brent Road**

Location

Kind of Pipe

Size **6" A.C.**

Size of Main **8"**

Repair—Renewal—New Service **Valeri Const. # 2451**


Location **APR 8 1974**

Date	Material	Amount	Total	Date	Amount	
11/26/73	25' 6" A.C. @ 9.00	\$225.00		12-10-73	Deposit	355.00
12-12-73	75' - 6" ACP					
	10' - 4' CI					

DATE _____

TOWN OF LEXINGTON — BOARD OF PUBLIC WORKS
SEWER DIVISION

Sketch of Service Here **11**

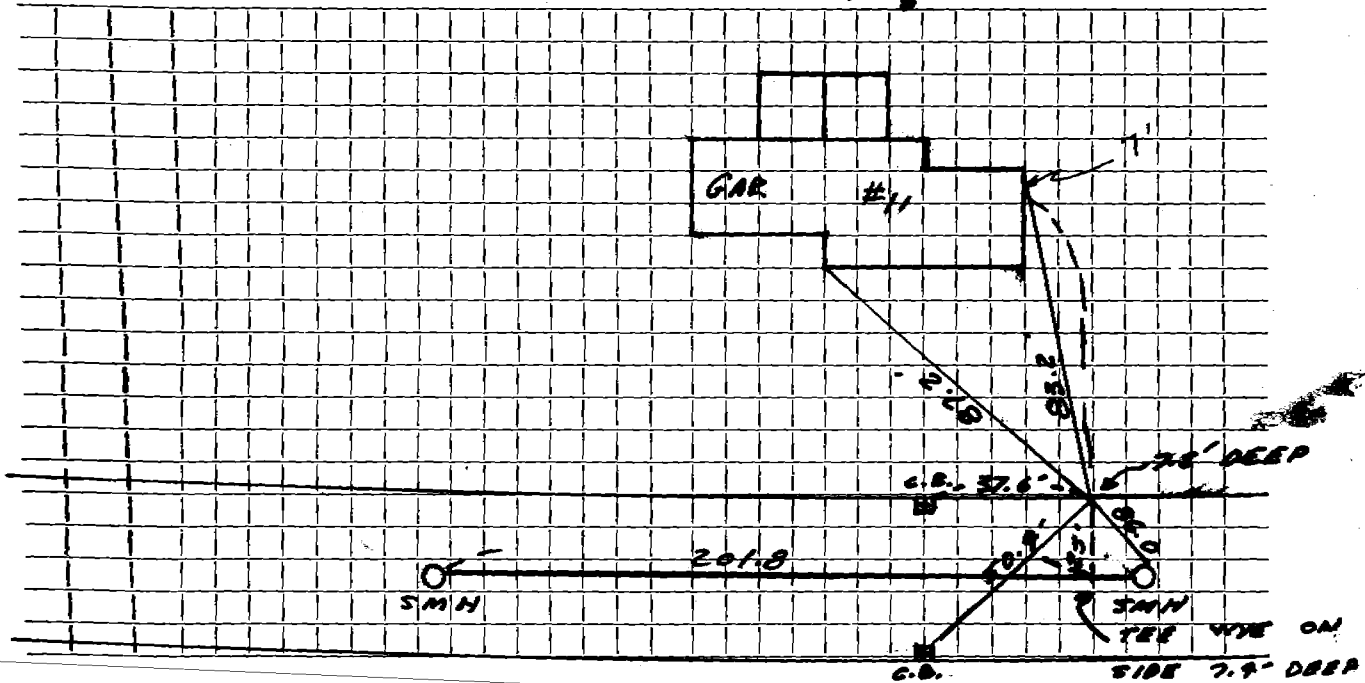

Connection made in Street. Work completed

Remarks:
.....
.....