


DATE _____

TOWN OF LEXINGTON — BOARD OF PUBLIC WORKS
SEWER DIVISION

Sketch of Service Here

14

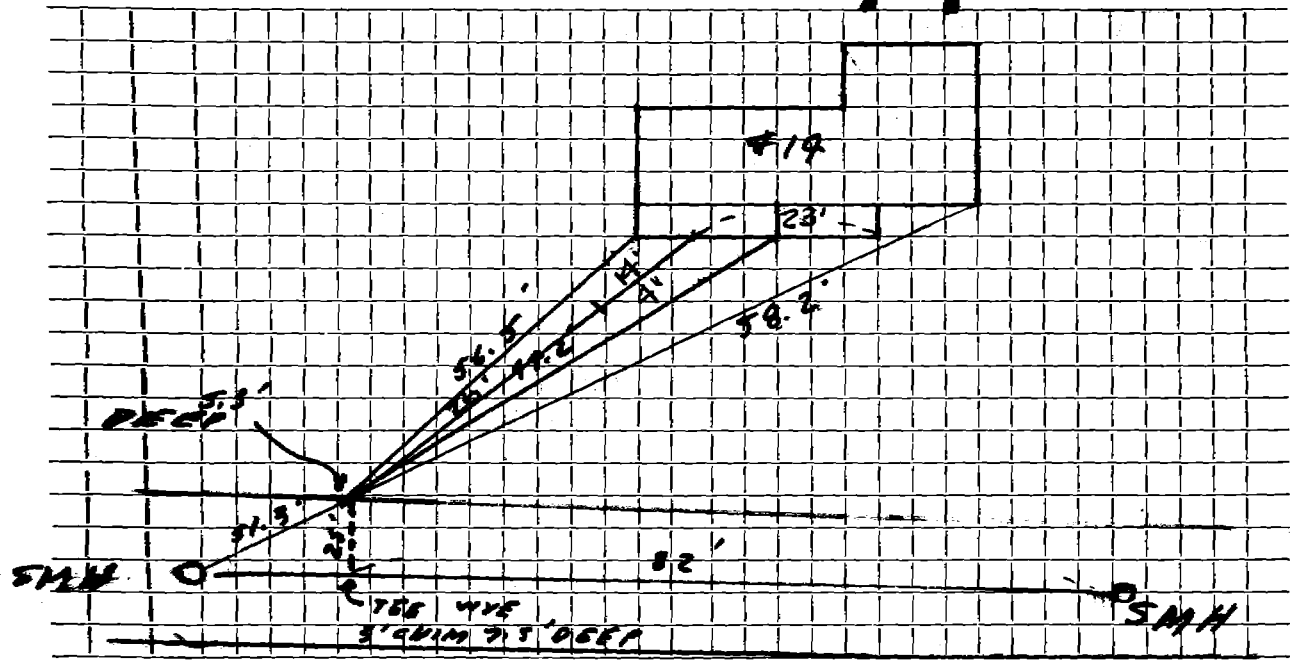

Connection made in BRENT RD. Street. Work completed 4-29-75

Remarks:

.....

.....