


DATE _____

TOWN OF LEXINGTON — BOARD OF PUBLIC WORKS
SEWER DIVISION

Sketch of Service Here **16**

NOTE: 7/8" 1" }
HOUSE SIDE OF
W/MAN

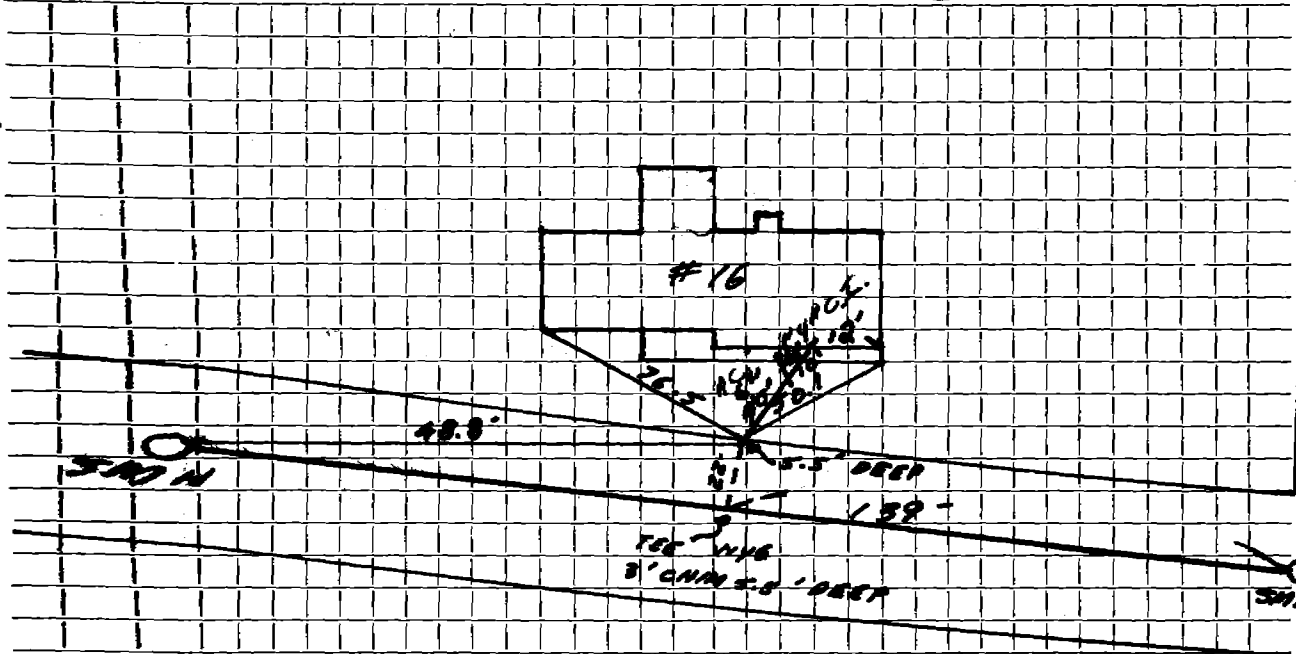

Connection made in **#16 BRENT RD.** Street.

Work completed **4/14/75**

Remarks:

.....

.....