




DATE \_\_\_\_\_

TOWN OF LEXINGTON — BOARD OF PUBLIC WORKS  
SEWER DIVISION

Sketch of Service Here **22**

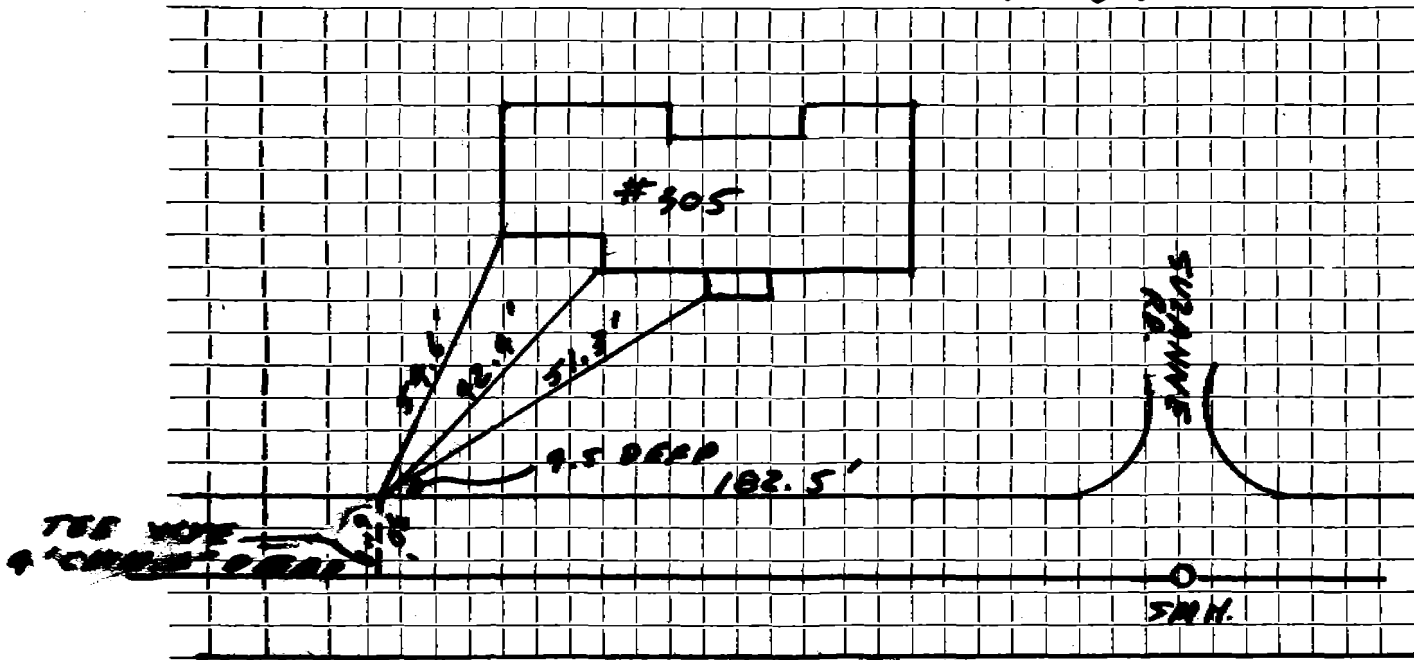

Connection made in . . . . . Street. Work completed . . . . .

Remarks: . . . . .

. . . . .

. . . . .