

Name Emanuel Sugerman

Service No. 185

Address 306 Emerson Road 23 Brent Rd.

Changed per Engineering 8/3/77

Location

Kind of Pipe Size 6" A.C

Size of Main 8"

Repair—Renewal—New Service Valeri Const. # 2439

Location APR 8 1974

Date	Material	Amount	Total	Date	Amount
11/16/73	35' of 6" A.C. @9.00	\$315.00		11-26-73	<i>Deposit</i> 315.00
12-10-73	57' - 6" ACP				
	10' - 4" CI				


DATE _____

TOWN OF LEXINGTON — BOARD OF PUBLIC WORKS

SEWER DIVISION

Sketch of Service Here

23

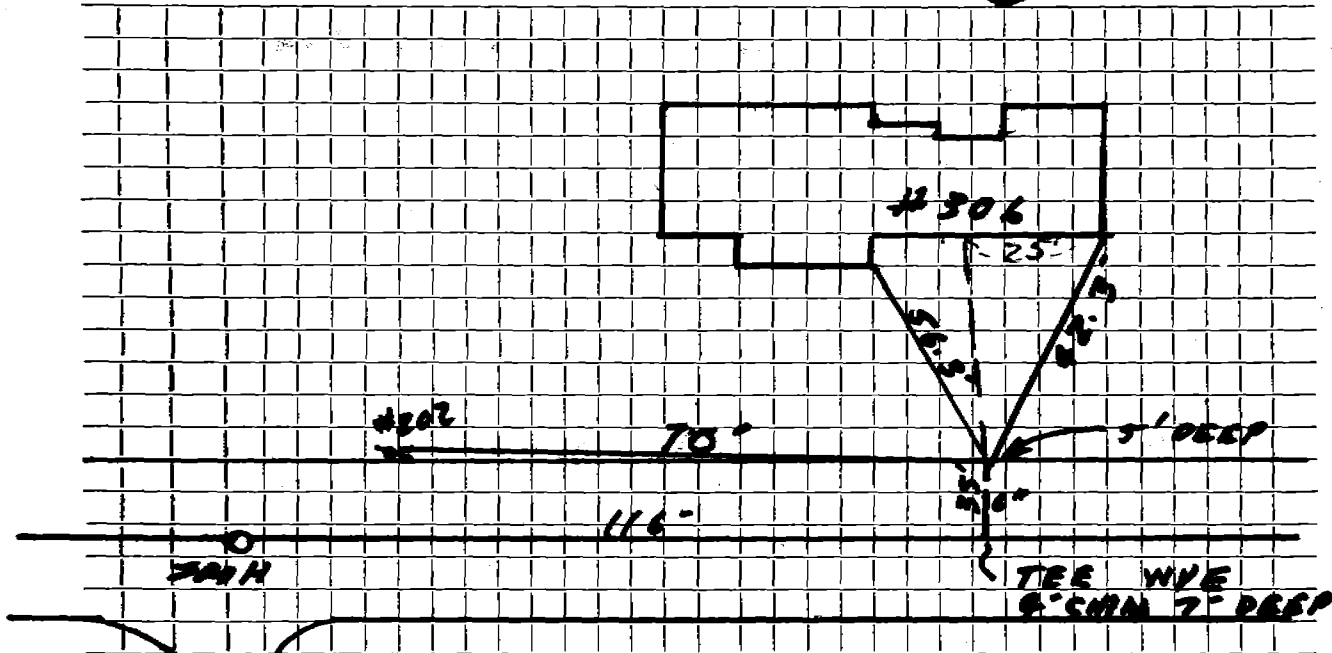

Connection made in Street. Work completed

Remarks:

.....
.....