




DATE \_\_\_\_\_

# TOWN OF LEXINGTON — BOARD OF PUBLIC WORKS

## SEWER DIVISION

Sketch of Service Here

25

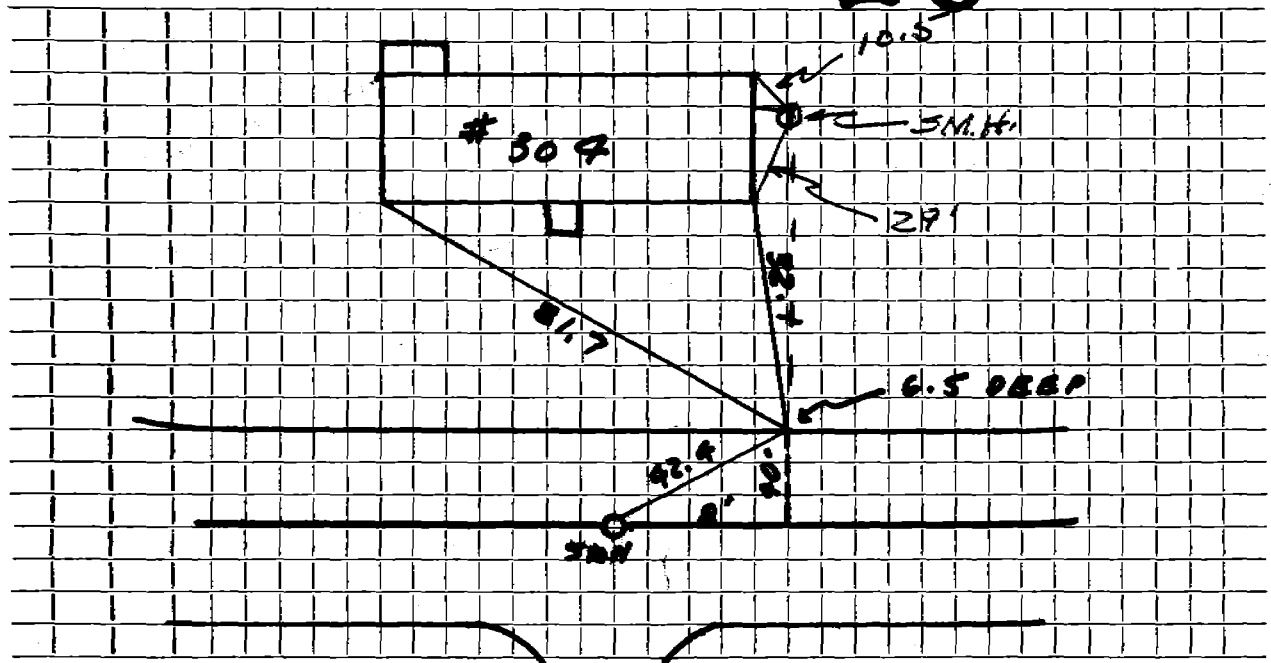

Connection made in ..... Street **SUZANNE RD.** Work completed .....

Remarks: .....

.....

.....