


DATE _____

TOWN OF LEXINGTON — BOARD OF PUBLIC WORKS

SEWER DIVISION

Bit. Drive

Sketch of Service Here **26**

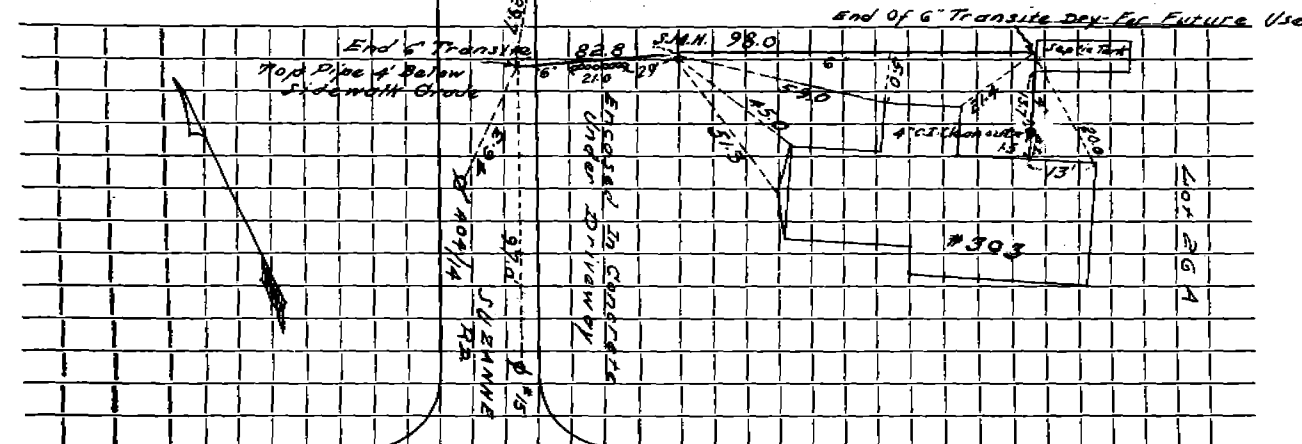

M E A S O N

A. D.

Connection made in Street. Work completed

Remarks:


.....

.....

TOWN OF LEXINGTON — BOARD OF PUBLIC WORKS
SEWER DIVISION

Sketch of Service Here

Note: This service for No. #303 Emerson Rd.

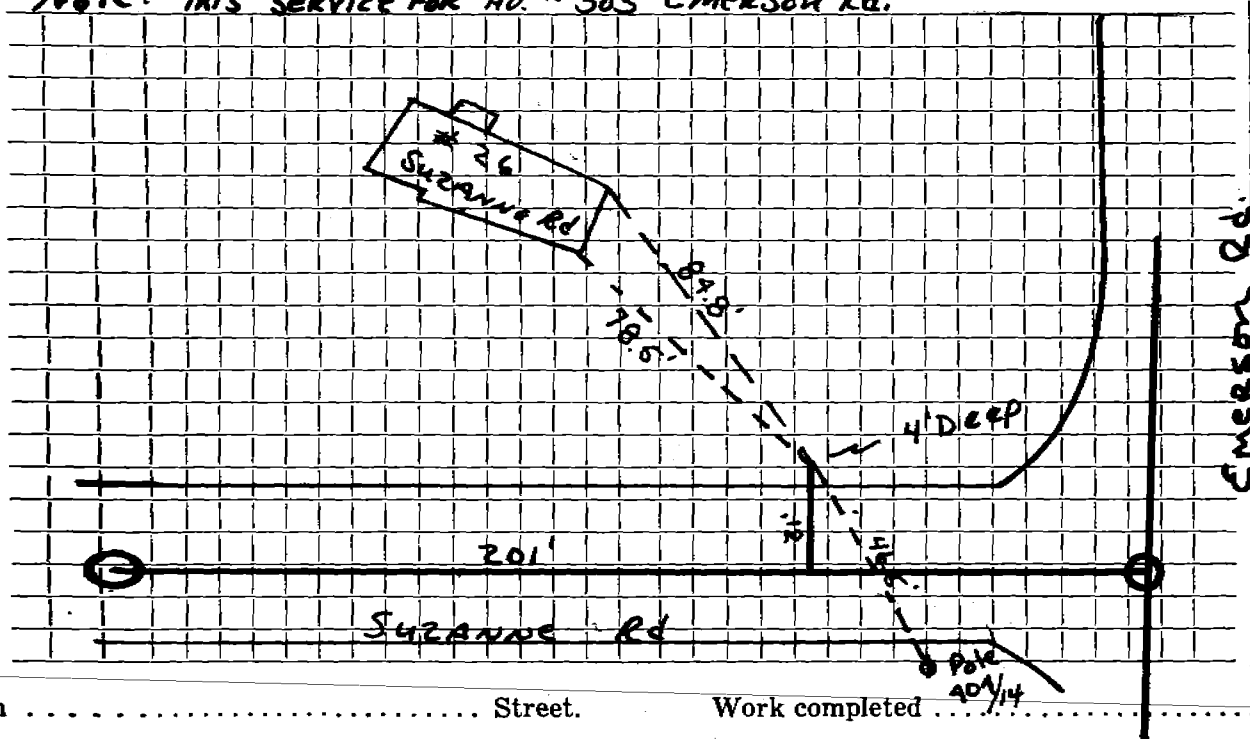

Connection made in Street. Work completed

Remarks:
.....
.....