

Name Martin Schatzoff

Service No. 187

Address 502-Emerson-Road 27 Brent Road

Changed per engineering dept. 8/3/77

Location

Kind of Pipe

Size 6" A.C.

Size of Main 8"

Repair—Renewal—New Service Valeri Const. # 2441

Location APR 8 1974


Date	Material	Amount	Total	Date	Amount
11/16/73	39' 6" A.C. @ 9.00	\$351.00		11-17-73	351.00
12-4-73	61' - 6" ACP			Deposit	
	5' - 4" CI				

DATE _____

TOWN OF LEXINGTON — BOARD OF PUBLIC WORKS
SEWER DIVISION

Sketch of Service Here

27

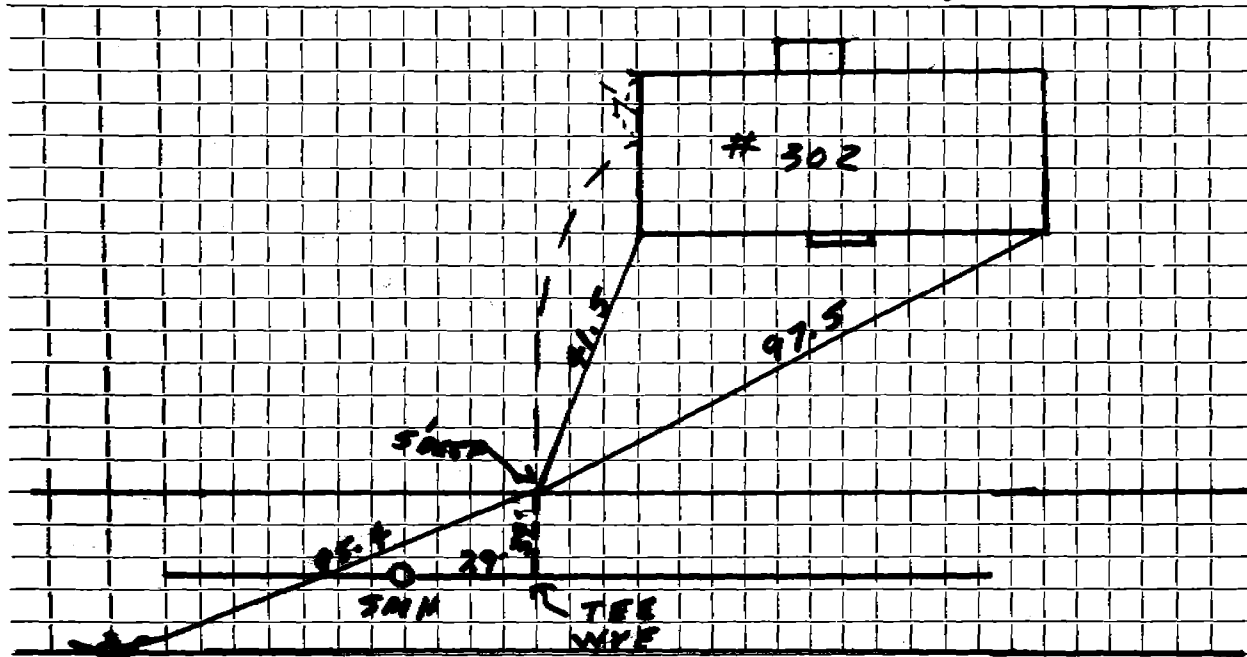

Connection made in N.Y.O. Street. Work completed

Remarks:

.....

.....