

Name

Service No.

Address 3 Brent Rd.

Location

Kind of Pipe

Size

Size of Main

Repair—Renewal—New Service

Location

Date

Material

Amount

Total

Date

Amount

April 2, 2002

8' 4" PVC

57' 6" PVC


1- 4"x6" Fernco

1- 6" 22.5° Bend

DATE April 2, 2002

**TOWN OF LEXINGTON — BOARD OF PUBLIC WORKS**  
**SEWER DIVISION**

Sketch of Service Here

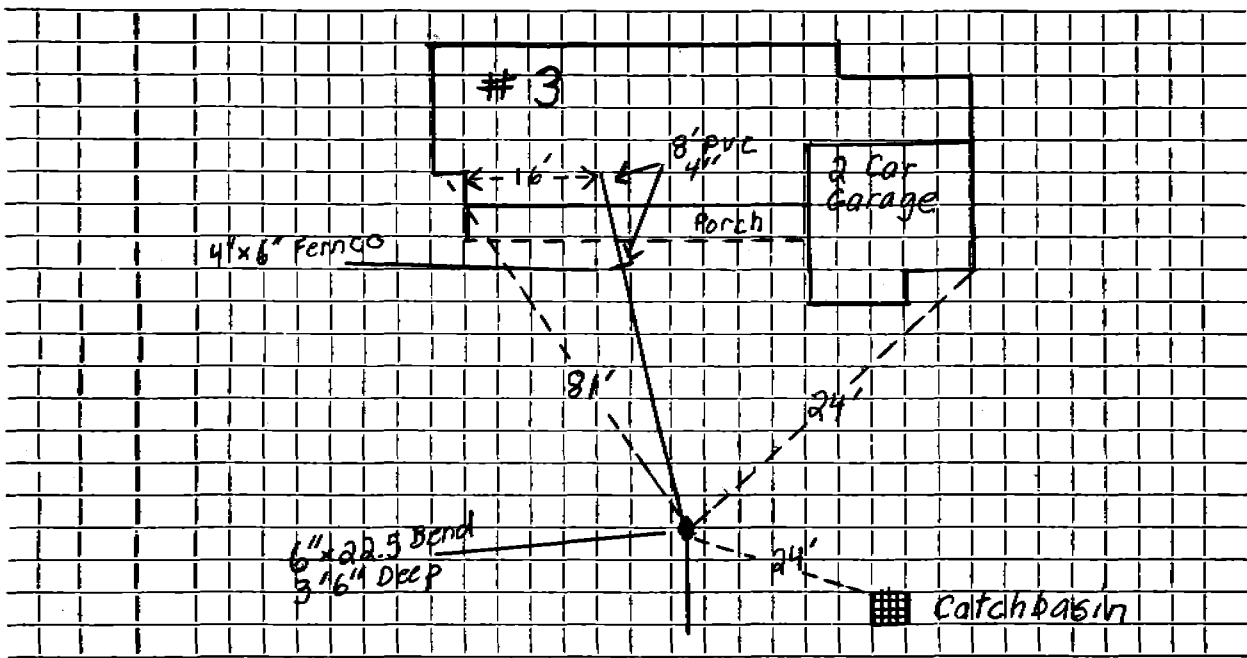

Connection made in ..... Street. Work completed .....

Remarks: .....  
.....  
.....