


DATE _____

TOWN OF LEXINGTON — BOARD OF PUBLIC WORKS
SEWER DIVISION

Sketch of Service Here

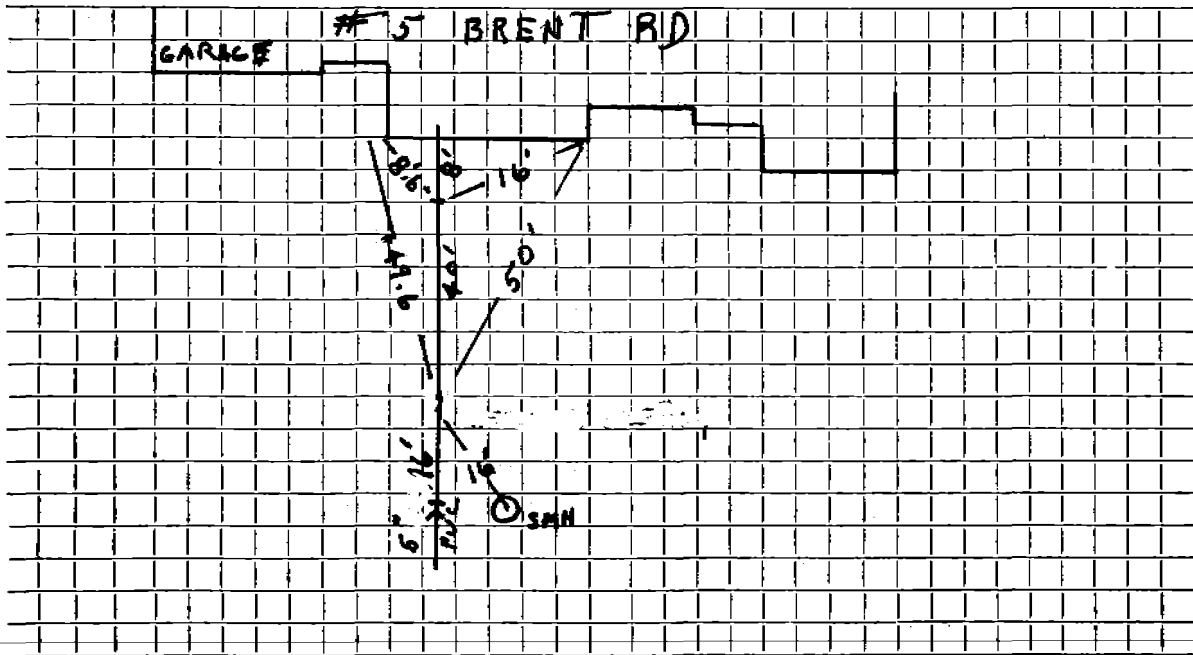

Connection made in Street. Work completed 12/99

Remarks: SEWER 4' DOWN IN ST 1' ABOVE WATER WHEN IT CROSSES SERVICE

.....
.....