


DATE 6/8/88

TOWN OF LEXINGTON — BOARD OF PUBLIC WORKS

SEWER DIVISION

Sketch of Service Here **14**

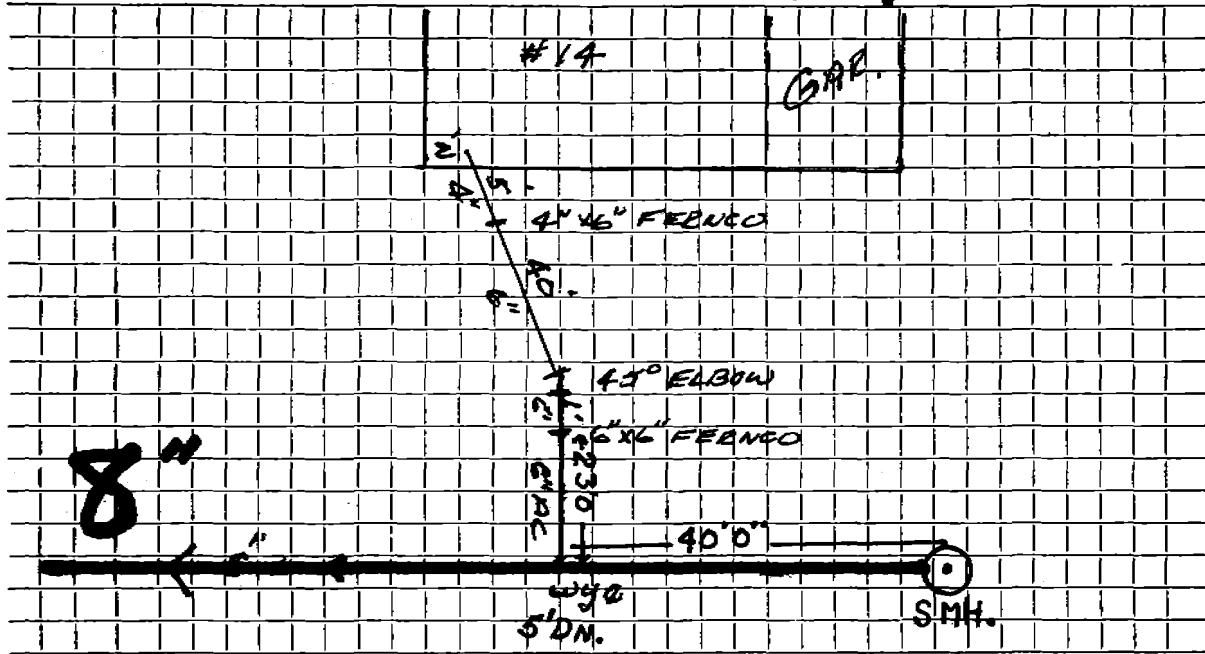

Connection made in BRIDLE PATH Street. Work completed

Remarks: SERVICE IS CONC. ENCASED.

.....
.....