




DATE AUGUST 1972

TOWN OF LEXINGTON — BOARD OF PUBLIC WORKS  
SEWER DIVISION

Sketch of Service Here

16

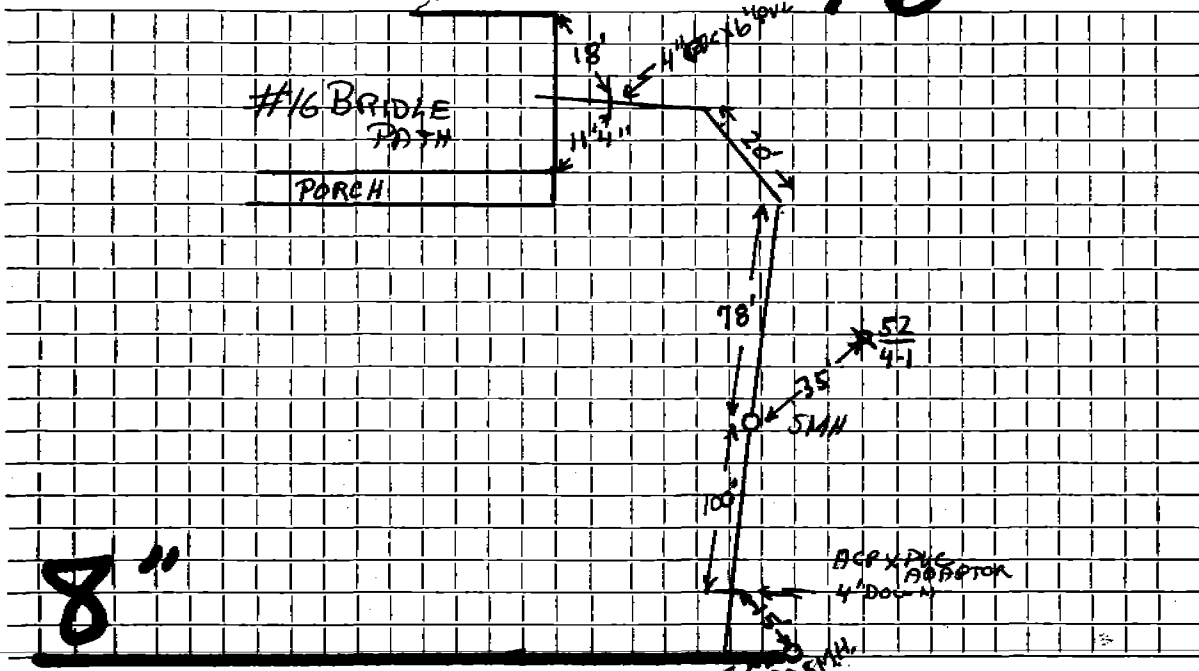

Connection made in BRIDLE PATH Street. Work completed .. Nov. 1984

Remarks: .....