

Name Owen S. Lafley

Service No. 145

Address #18 BRIDLE PATH

JUN 18 1973

Location

Kind of Pipe

Size

6"

Size of Main

8"

~~Repair~~ - New Service Valeri Construction #2144


Location

Date		Material	Amount	Total	Date	Amount
8/30/72	15'	6" Transite @9.00	\$ 135.00		9-5-72	135.00
9/5/72		6" TRANS IN SIDE			8-30-72	
					15' 6" Transite	

DATE _____

TOWN OF LEXINGTON — BOARD OF PUBLIC WORKS
SEWER DIVISION

Sketch of Service Here **18**

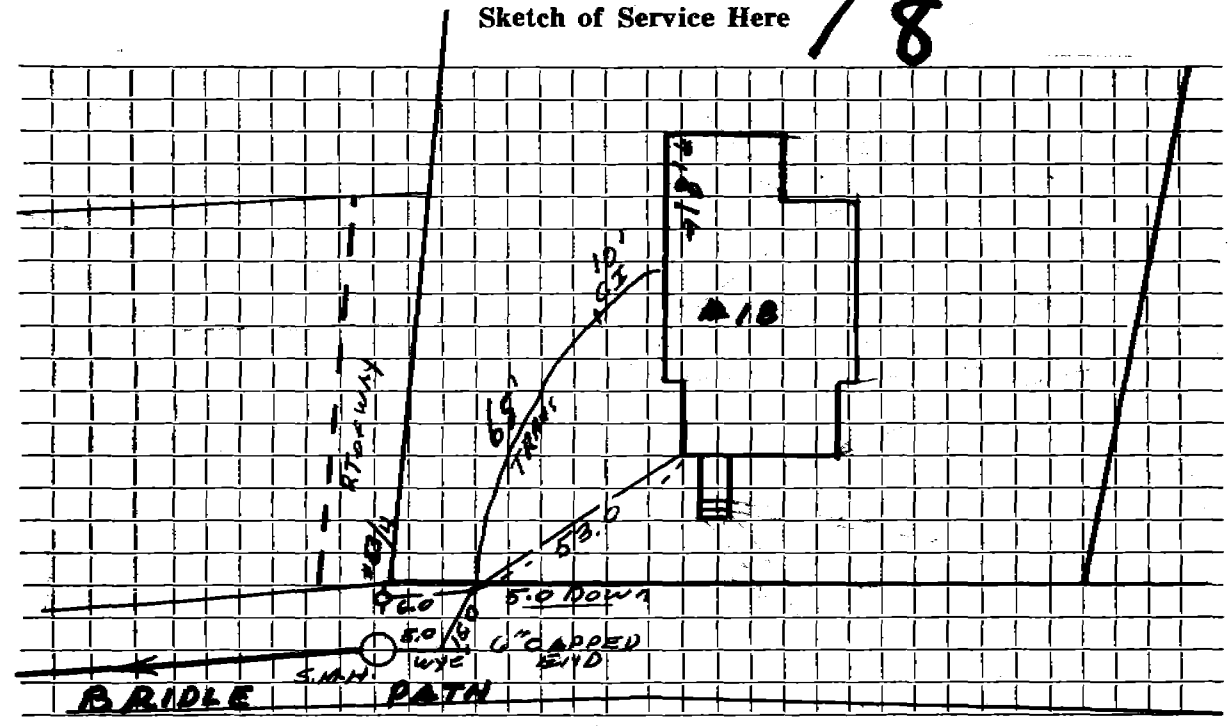

Connection made in Street. Work completed

Remarks:
.....
.....