

Name Ivar Skoog

Service No. 159

Address 14 Bridge Street

Location

Kind of Pipe Permit #485

Size

Size of Main

~~Repair~~ ~~Renewal~~ New Service T.D.Sullivan & Sons

Location


DEC 31 1961

Date		Material	Amount	Total	Date		Amount
1965	23'	6" Transite pipe @7.00		161.00	9-16-65	Deposit	161.00
9-13-65	30'	6" Transite pipe					

DATE \_\_\_\_\_

**TOWN OF LEXINGTON — BOARD OF PUBLIC WORKS**  
**SEWER DIVISION**

Sketch of Service Here **14**

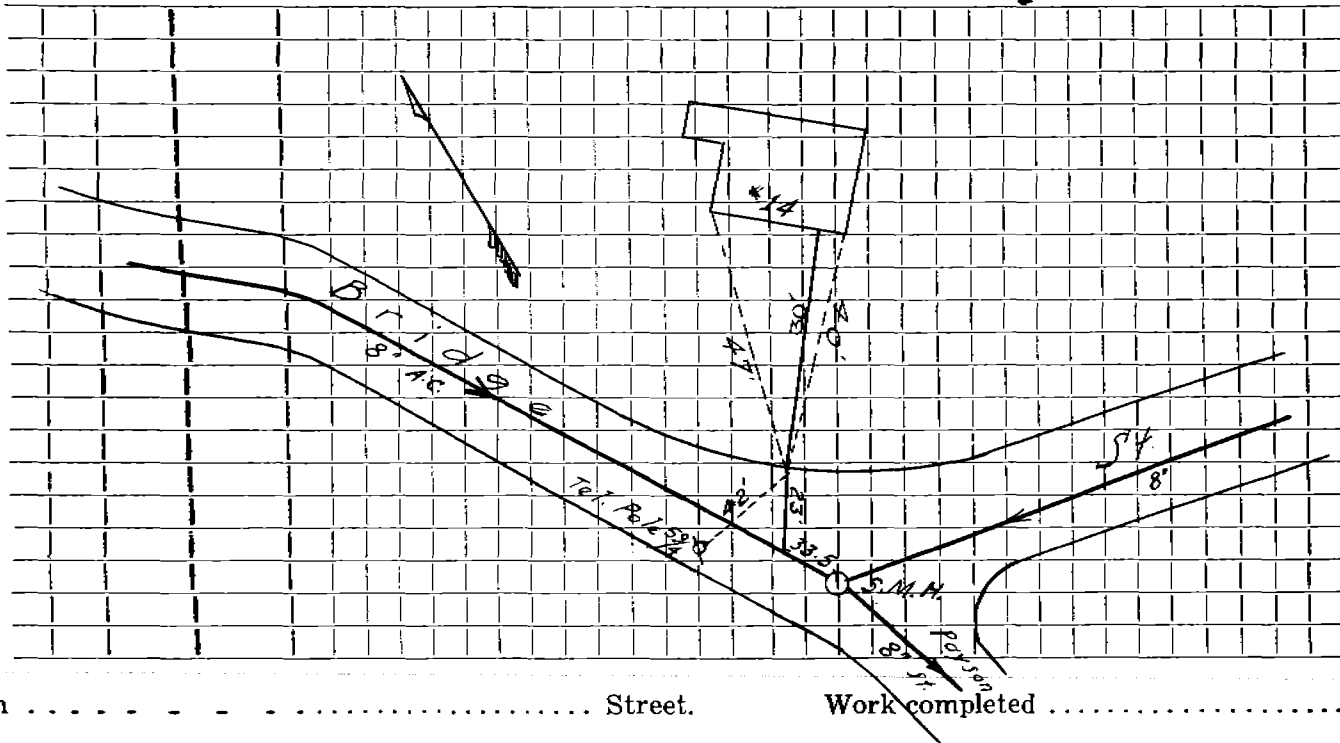

Connection made in ..... Street. Work completed .....

Remarks: .....