

Name

Service No.

Address 15 BRIDGE

GULLAHO JR

Location

Kind of Pipe

Size

Size of Main

Repair—~~Renewal~~—New Service

Location

Date

Material

Amount

Total

Date

Amount

9/20/14

6" SDR

6" CLEAN OUT

6" CAP

-6" SDR RISER

-6" TEE W/6"


6" x 6" FERNICO

DATE 9/2011

TOWN OF LEXINGTON — BOARD OF PUBLIC WORKS

SEWER DIVISION

Sketch of Service Here

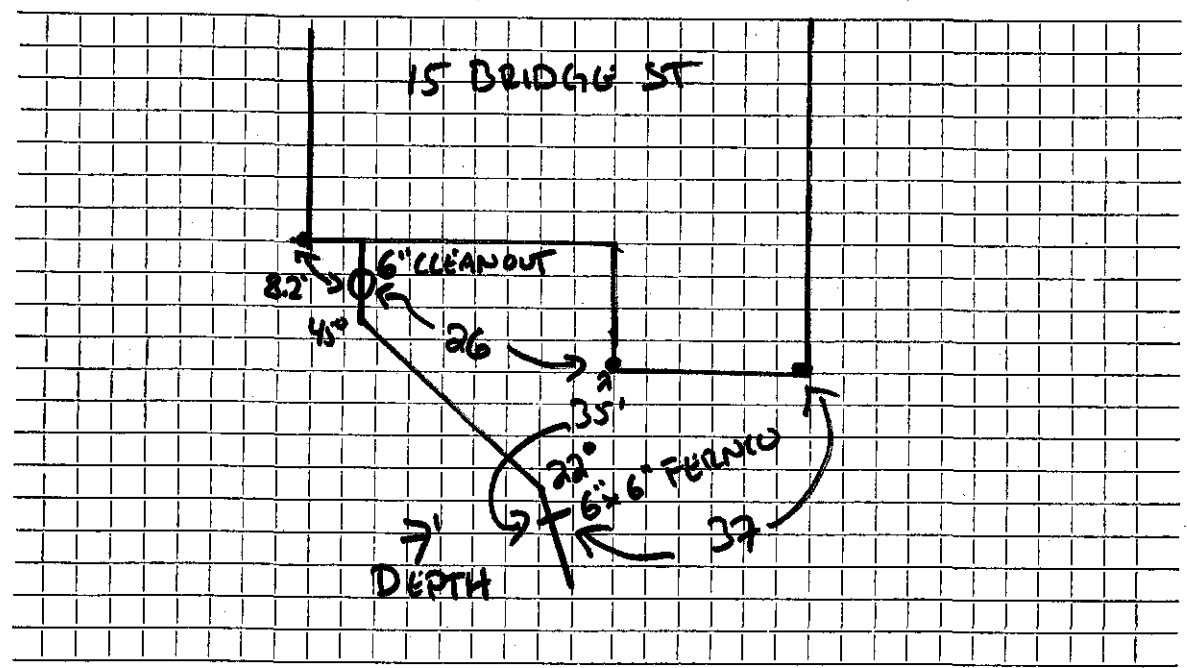

Connection made in BRIDGE Street.

Work completed GREG GULLAGH, JR.

Remarks:

.....

.....