

Name

Service No.

Address 22 Bridge St.

Location

Kind of Pipe AC

Size 6"

Size of Main

Repair—Renewal—New Service *Trabino # 2478*

Location


Date	Material	Amount	Total	Date		Amount
4-22-74	5' 4" CI					
	72' 6" AC			1965	26' Transite	

DATE _____

TOWN OF LEXINGTON — BOARD OF PUBLIC WORKS
SEWER DIVISION

Sketch of Service Here

22

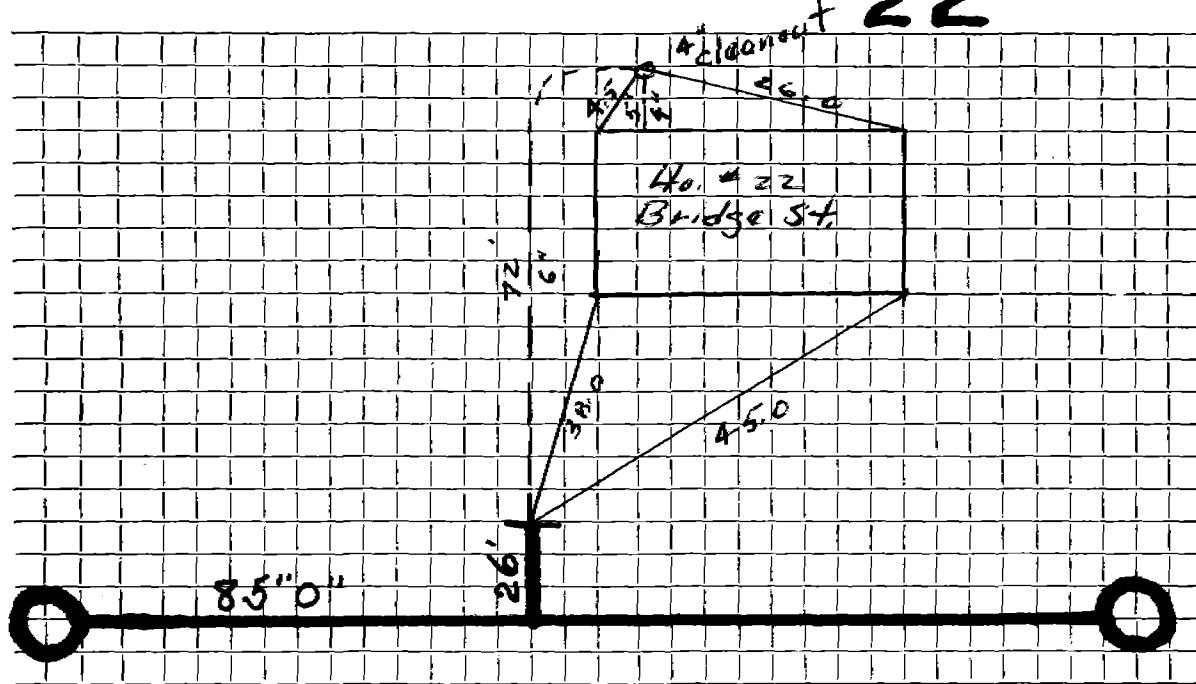

Connection made in Bridge St. Street. Work completed

Remarks: Original Service '65'