


DATE 1965

TOWN OF LEXINGTON — BOARD OF PUBLIC WORKS
SEWER DIVISION

Sketch of Service Here **24**

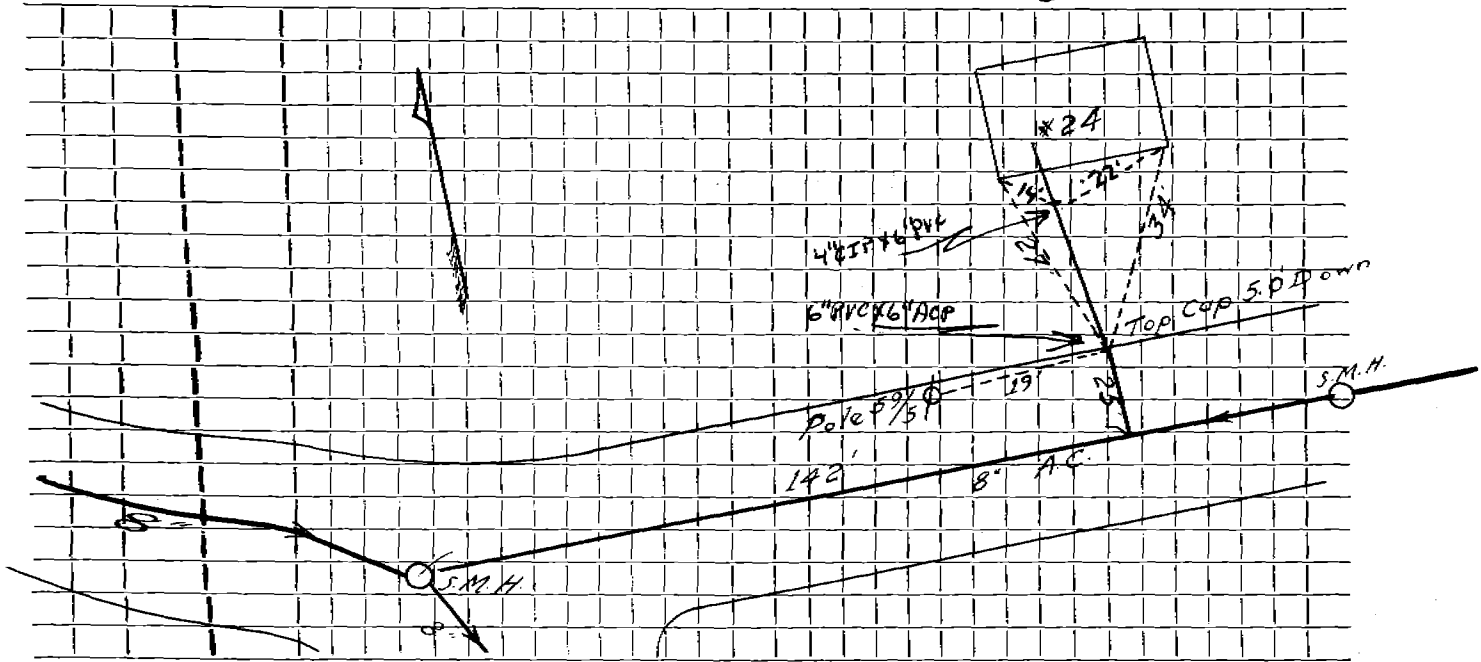

Connection made in BRIDGE ST Street. Work completed SEPT 1, 1983

Remarks: