

Name

Service No.

Address 27 Bridge Street Lot #148

Location

Kind of Pipe

Size

Size of Main

Repair—Renewal—New Service

Location

Date

Material

Amount

Total

Date

Amount

1965

25'

Transite pipe @ 7.00


\$175 00

DATE _____

TOWN OF LEXINGTON — BOARD OF PUBLIC WORKS

SEWER DIVISION

Sketch of Service Here **27**

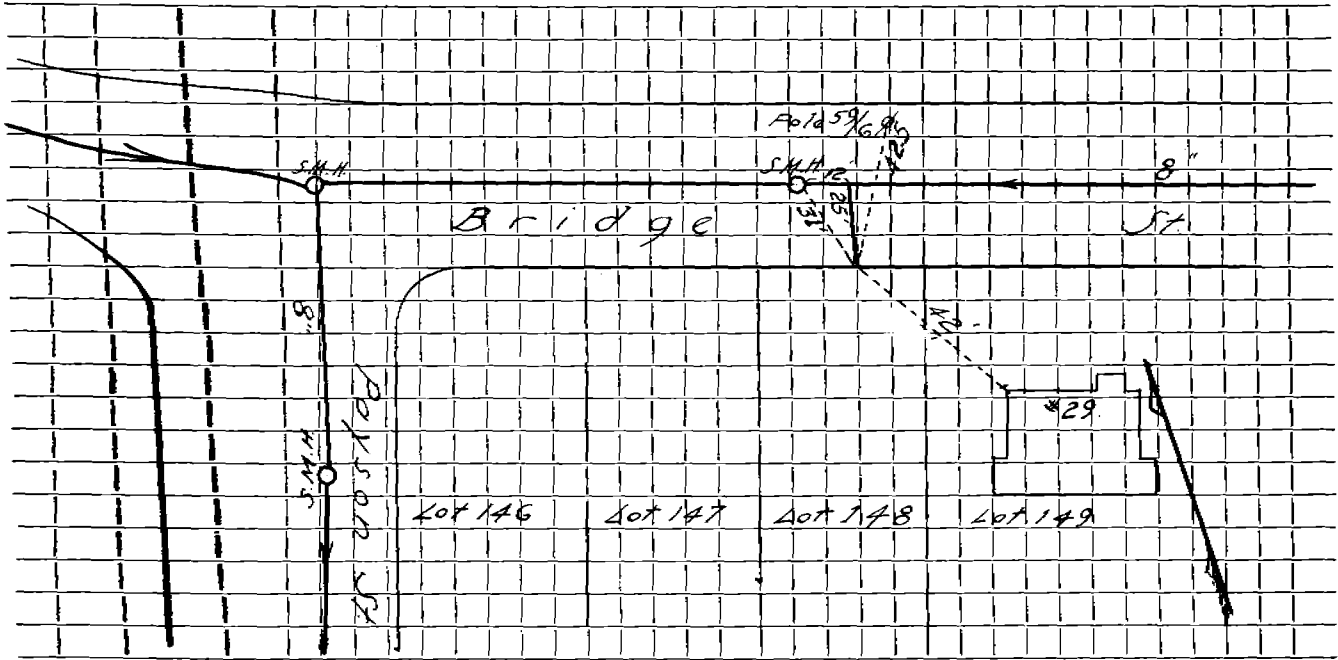

Connection made in _____ Street. Work completed _____

Remarks: _____
