

Name Leon Sherlock

Service No. 52

Address 32 Bridge Street

Location

Kind of Pipe

Size

Size of Main

Repair—Renewal—New Service

Devine #2049

Location

JUN 5 1972


Date		Material	Amount		Total	Date			Amount
1965	26'	Transite pipe @ 7.00			\$182 00	5-1-72	Deposit		182 00
5-2-72	50'	6" Transite pipe							
	10'	4" Cast Iron pipe							

DATE \_\_\_\_\_

# TOWN OF LEXINGTON — BOARD OF PUBLIC WORKS

## SEWER DIVISION

Sketch of Service Here **32**

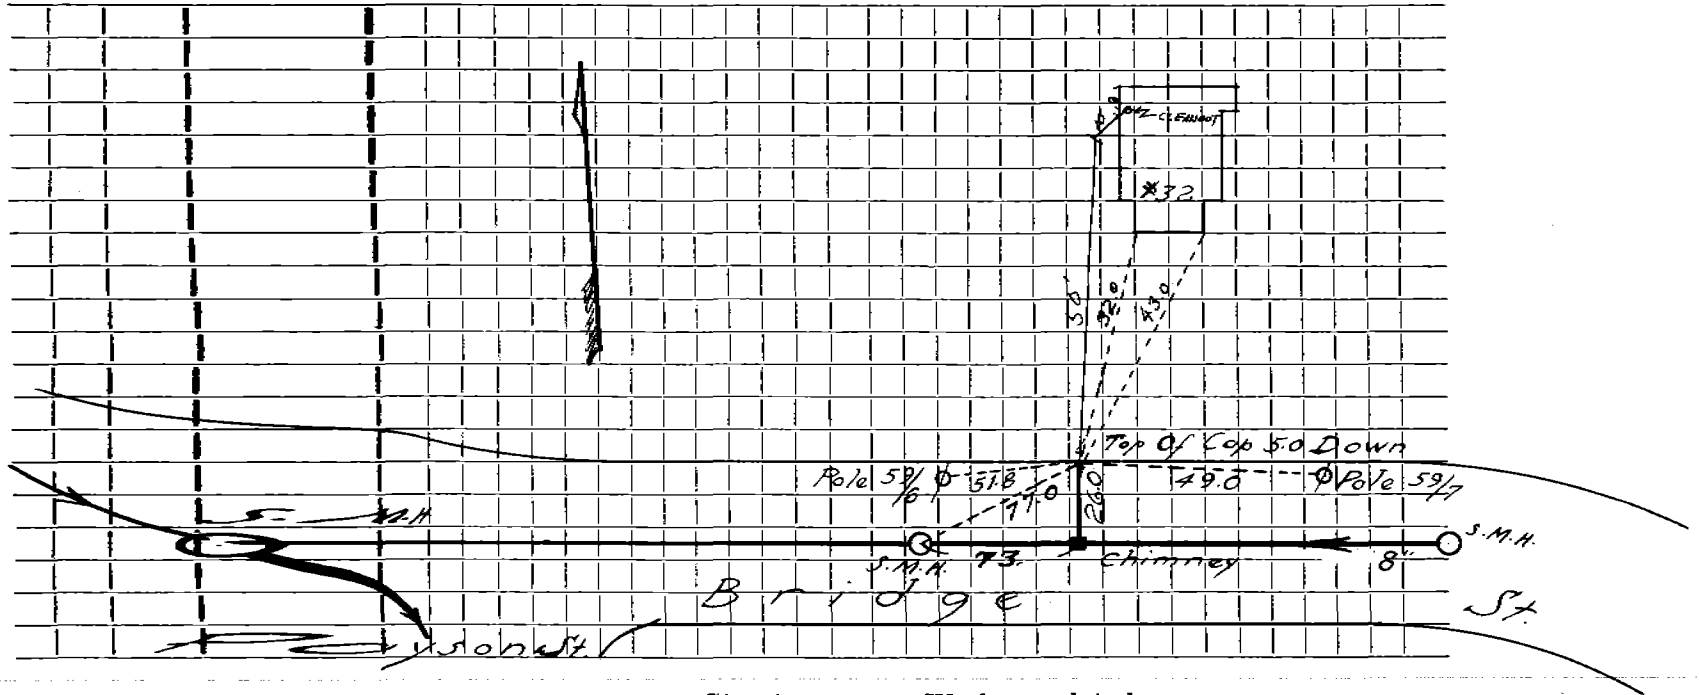

Connection made in \_\_\_\_\_ Street. Work completed \_\_\_\_\_

Remarks: \_\_\_\_\_  
\_\_\_\_\_  
\_\_\_\_\_