

Name Dimitri Zaitz

Service No. 220

Address 34 Bridge Street

Location

Kind of Pipe Russell Sibley Permit #A70

Size

Size of Main

~~Repair/Replacement~~ New Service

Location

MAY 2 1966


Date		Material	Amount	Total	Date	Amount
1965	25'	Transite pipe @ 7.00		\$175 00	11-4-65	175.00
12/1/65	30'	6" Transite pipe				

DATE \_\_\_\_\_

# TOWN OF LEXINGTON — BOARD OF PUBLIC WORKS

## SEWER DIVISION

Sketch of Service Here **34**

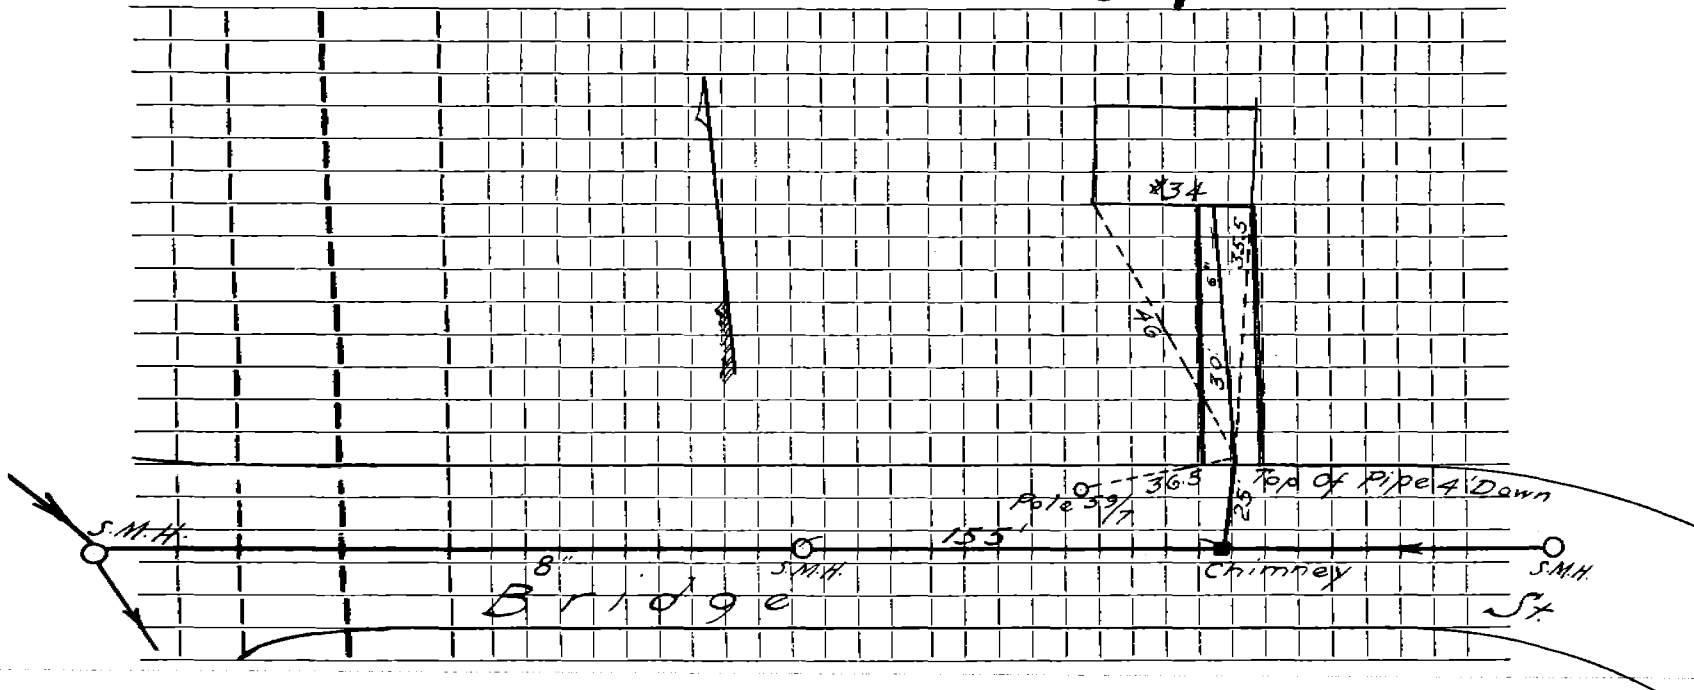

Connection made in \_\_\_\_\_ Street. Work completed \_\_\_\_\_

Remarks: \_\_\_\_\_

\_\_\_\_\_

\_\_\_\_\_

\_\_\_\_\_