

Name

Service No.

Address 39 Bridge Street

Location

Kind of Pipe

Size

Size of Main

Repair—Renewal—New Service


Location

| Date | Material | Amount | Total | | Date | | Amount |
|-----------------|--|--------|-------|----|------|-----------------|--------|
| 1965 | 20' Transite pipe @ 7.00 | | \$140 | 00 | | | |
| | | | | | | | |
| | | | | | | 1965 | |
| | | | | | | 20' 6" Transite | |
| | | | | | | | |
| | | | | | | | |
DATE _____

TOWN OF LEXINGTON — BOARD OF PUBLIC WORKS
SEWER DIVISION

Sketch of Service Here **39**

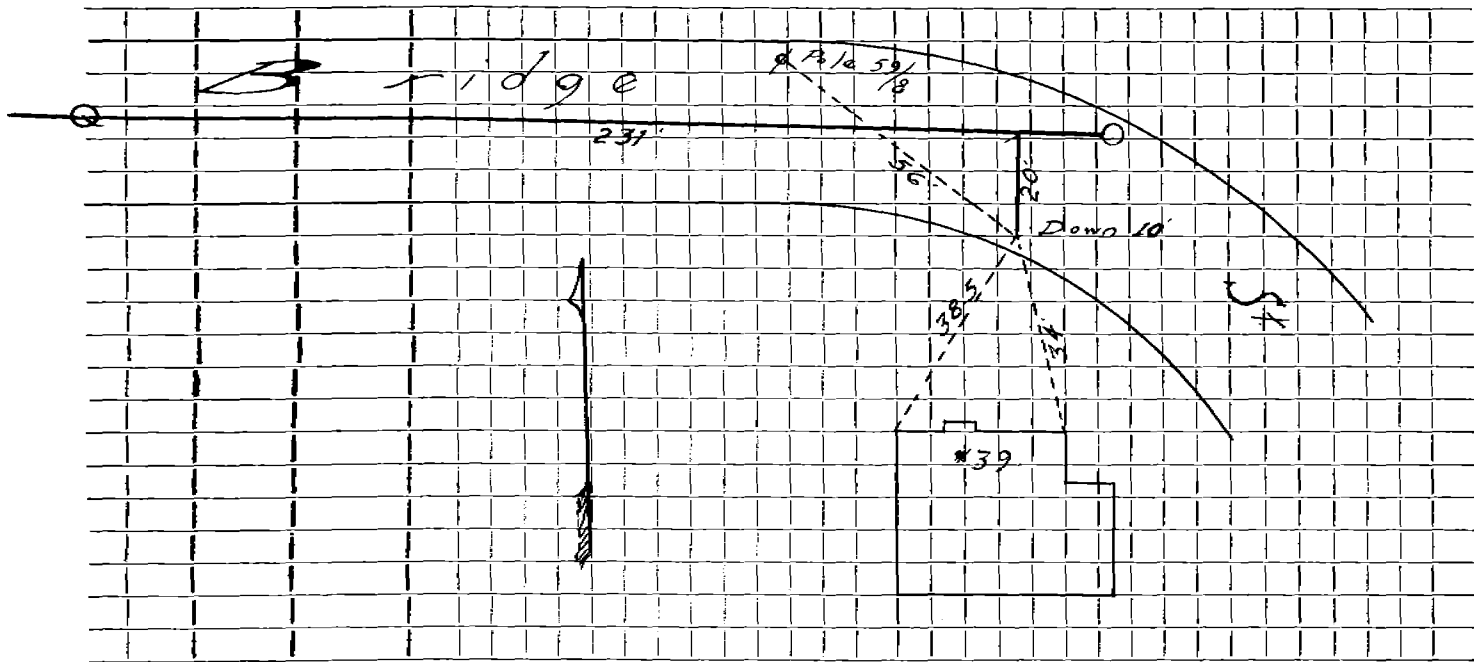

Injection made in Street. Work completed

marks:
.....
.....