

Name

Service No.

Address 42 Bridge Street

Lot #128

Location

Kind of Pipe

Size

Size of Main

Repair—Renewal—New Service

Location

Date	Material	Amount	Total	Date	Amount
Jul 166	21' 6" Transite pipe @5.00		105.00		
				7- -66	
				21' 6" Transite	


DATE _____

TOWN OF LEXINGTON — BOARD OF PUBLIC WORKS

SEWER DIVISION

Sketch of Service Here

42

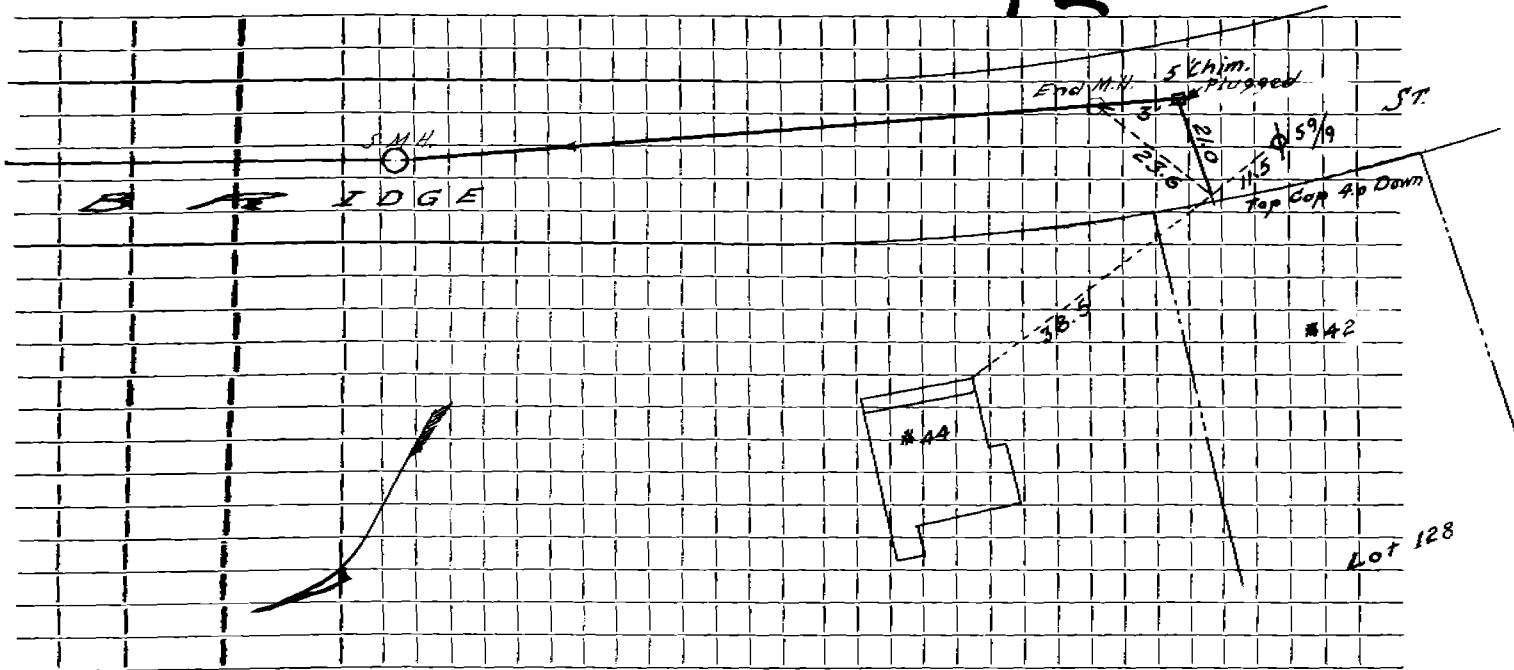

Connection made in _____ Street. Work completed _____

Remarks: _____

Name

Service No.

Address 42 Bridge Street

Lot #128

Location

Kind of Pipe

Size

Size of Main

Repair—Renewal—New Service


Location

Date	Material	Amount	Total	Date	Amount
Jul 166	21' 6" Transite pipe @5.00	05.00	105.00	7- -66	21' 6" Transite

DATE _____

TOWN OF LEXINGTON — BOARD OF PUBLIC WORKS
SEWER DIVISION

Sketch of Service Here **42**

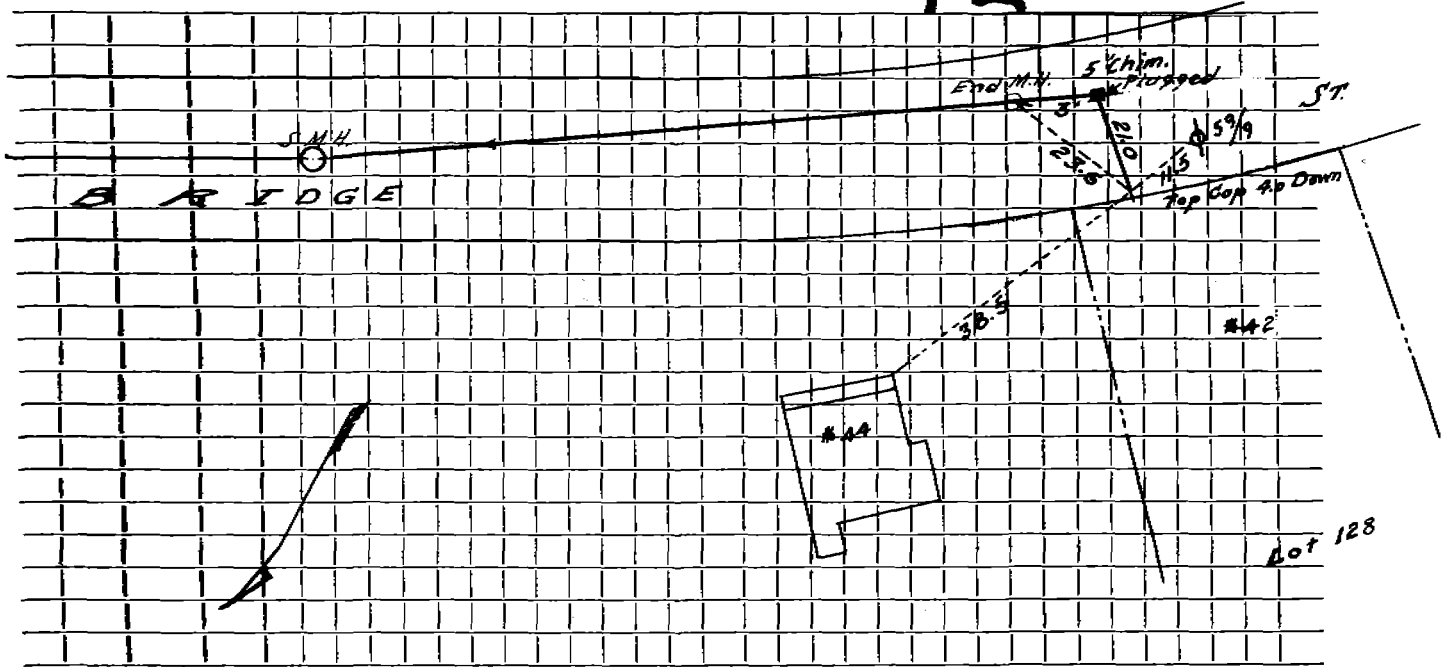

Connection made in Street. Work completed

Remarks:
.....
.....