


DATE _____

TOWN OF LEXINGTON — BOARD OF PUBLIC WORKS
SEWER DIVISION

Sketch of Service Here

46

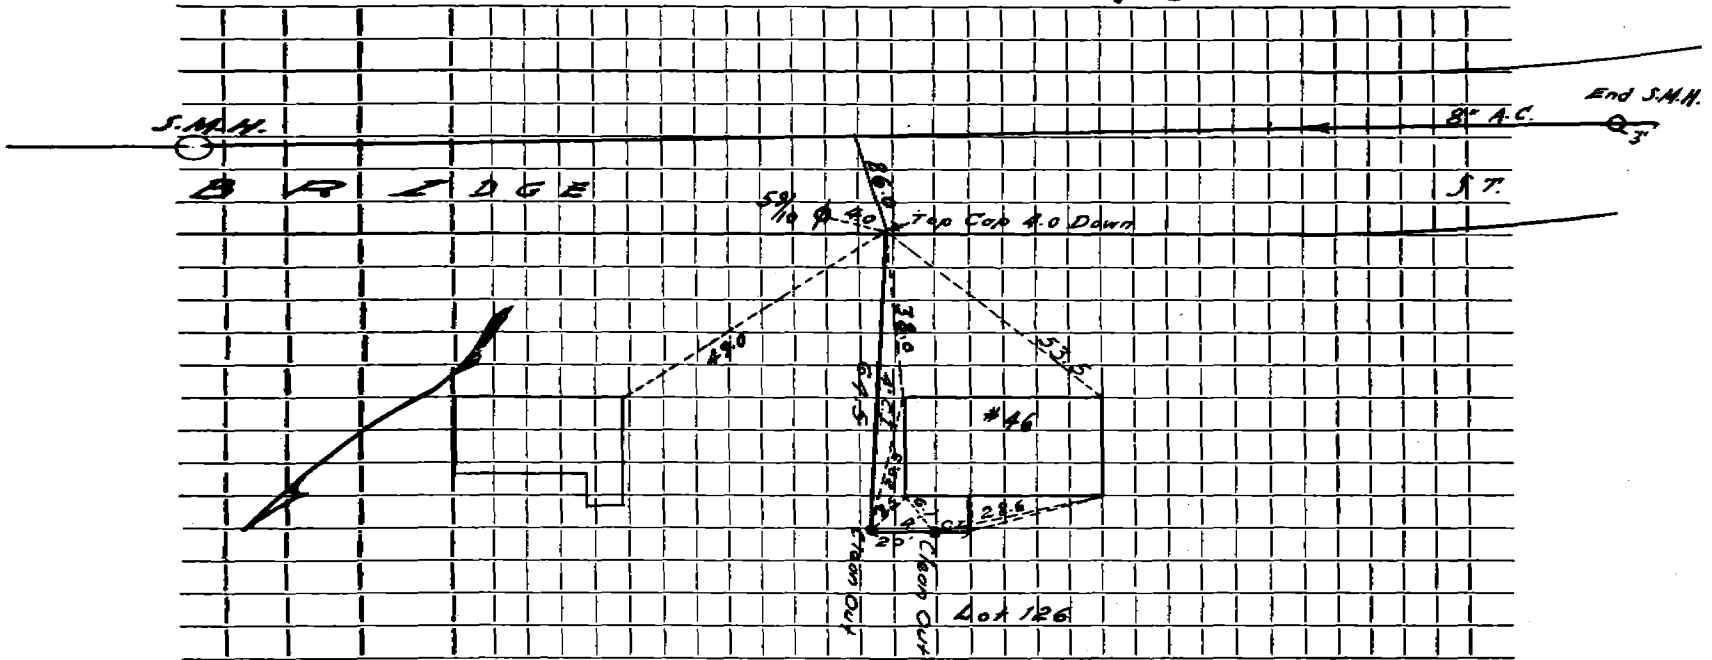

Connection made in _____ Street. Work completed _____

marks: _____
