

Name Walter McKenna

Service No. 56

Address 47 Bridge Street

Lot #154

Location

Kind of Pipe

Size

Size of Main

~~Suburbanite~~ New Service Suburbanite #3604

Location OCT 6 1980

Date		Material	Amount	Total	Date		Amount
Jul '66	19'	6" Transite pipe @5.00		95.00	9-26-80	Deposit	95
10-17-80	62'	A.C. pipe			7 - 66		
					19' 6" Transite		


DATE _____

TOWN OF LEXINGTON — BOARD OF PUBLIC WORKS

SEWER DIVISION

Sketch of Service Here

47

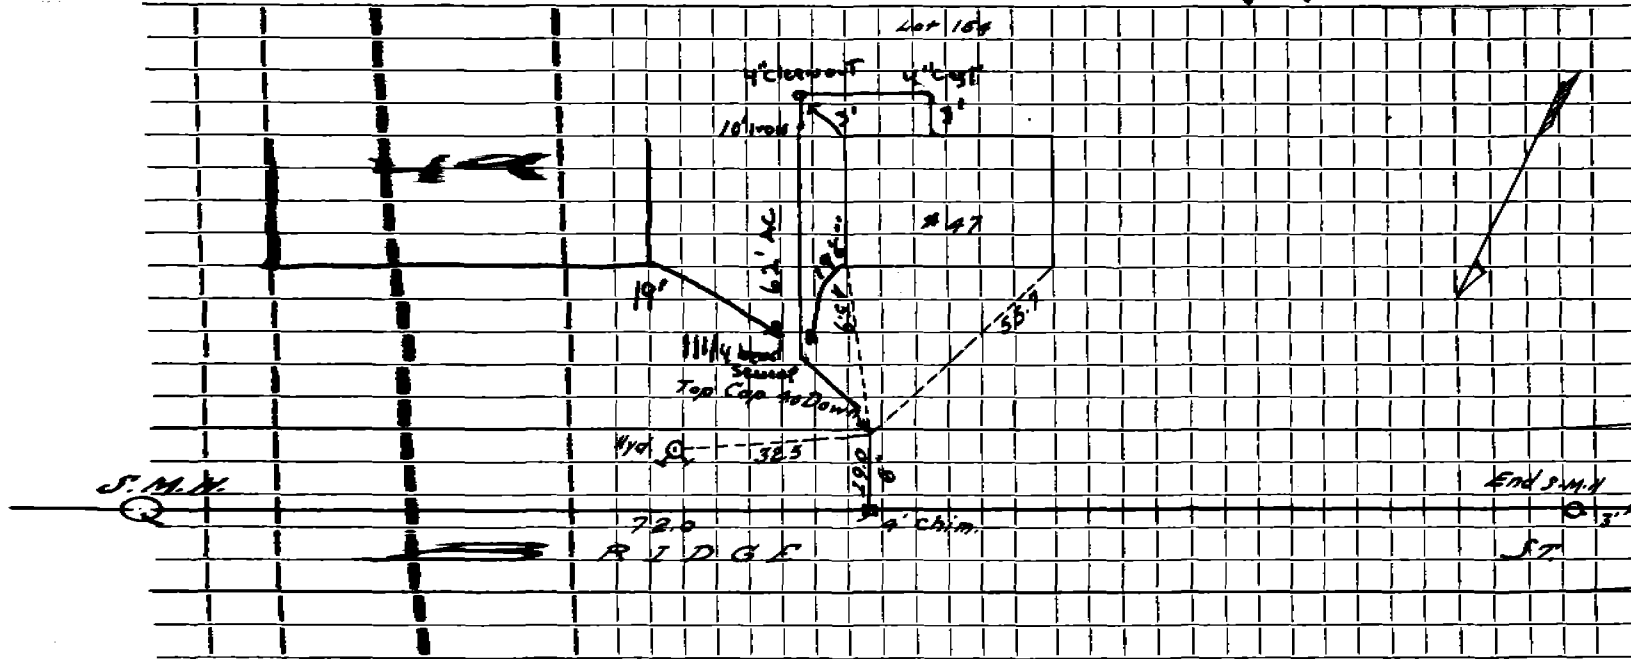

tion made in Street. Work completed

ks:

.....

.....