

Name

Service No.

Address 49 BRIDGE ST.

Location

Kind of Pipe PVC

Size 6"

Size of Main 8"


Repair—Renewal (New Service)

Location

Date	Material	Amount	Total	Date	Amount
12/1 88	<del>87'</del> 6" PVC 5 LF 4" PVC 2 - SMH'S				
				7 - - 66	
					26' 6" Transite

DATE \_\_\_\_\_

**TOWN OF LEXINGTON — BOARD OF PUBLIC WORKS**  
**SEWER DIVISION**

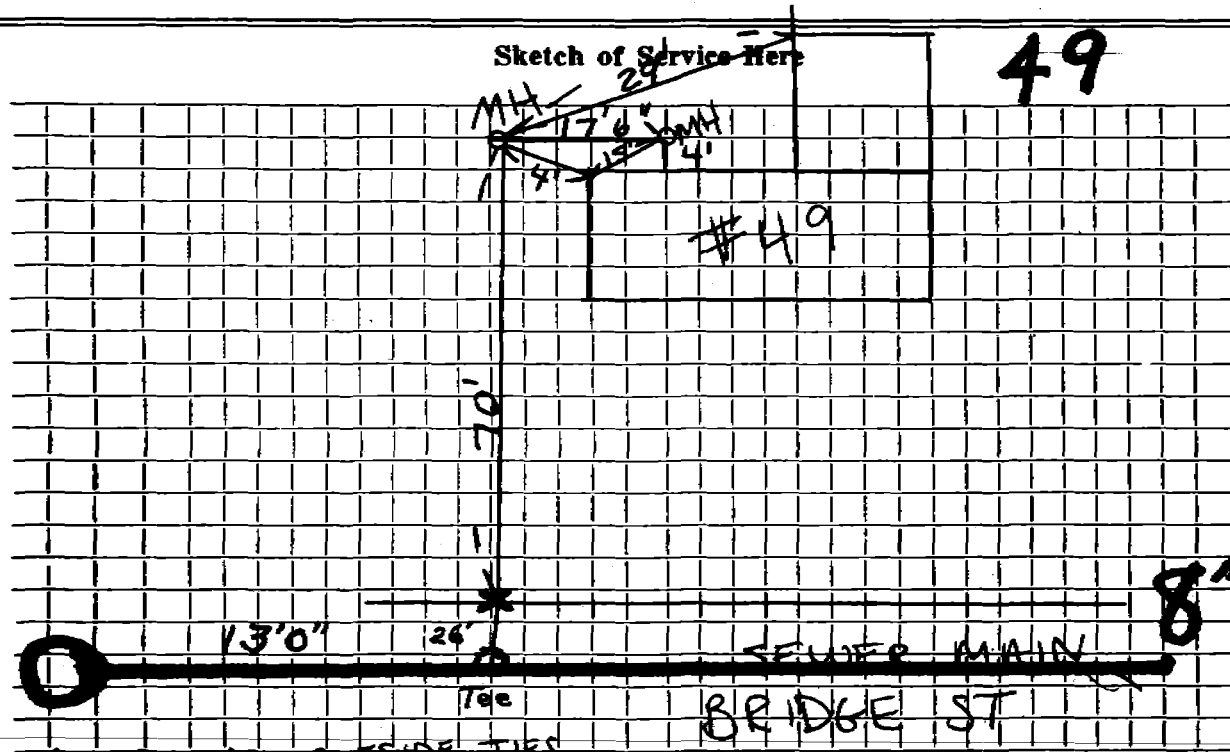

NOTE: NO OUTSIDE TIES

Connection made in BRIDGE ST. Street. Work completed .....

Remarks: .....

.....

.....