


DATE _____

TOWN OF LEXINGTON — BOARD OF PUBLIC WORKS
SEWER DIVISION

Sketch of Service Here

50

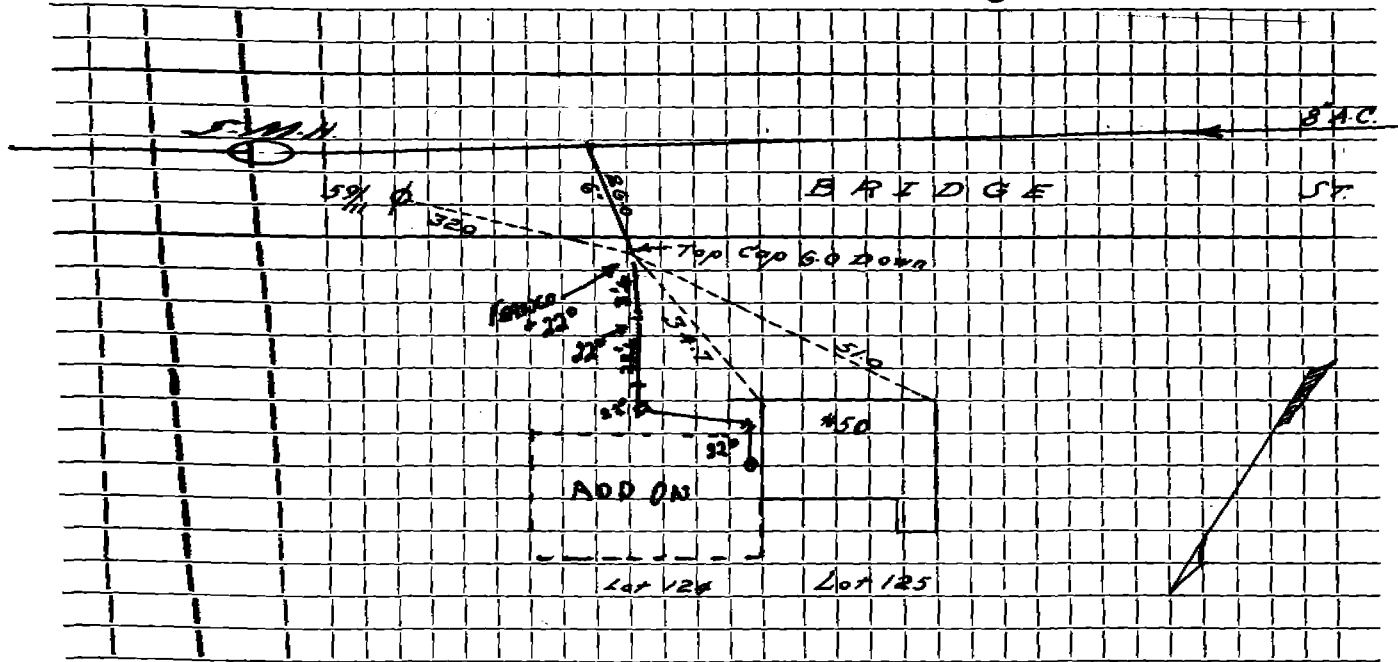

Connection made in Street. Work completed

Remarks: CAST IRON WAS NOT INSP BY D.P.W.