

Name George Pettinelli

Service No. 22

Address 51 Bridge Street

Lot #152

Location

Kind of Pipe

Size

Size of Main

Repair—Renewal—New Service Lexington Sewerage # 1009

Location AUG 5 1968


Date	Material	Amount	Total	Date	Amount
Jul 166	17' 6" Transite pipe @5.00		85.00	4-24-68	Deposit
5/9/68	10' 4" Cast Iron				
	37' 6" Transite Pipe			7- - 66	
				17' 6" TRANSITE	

DATE _____

TOWN OF LEXINGTON — BOARD OF PUBLIC WORKS

SEWER DIVISION

Sketch of Service Here **51**

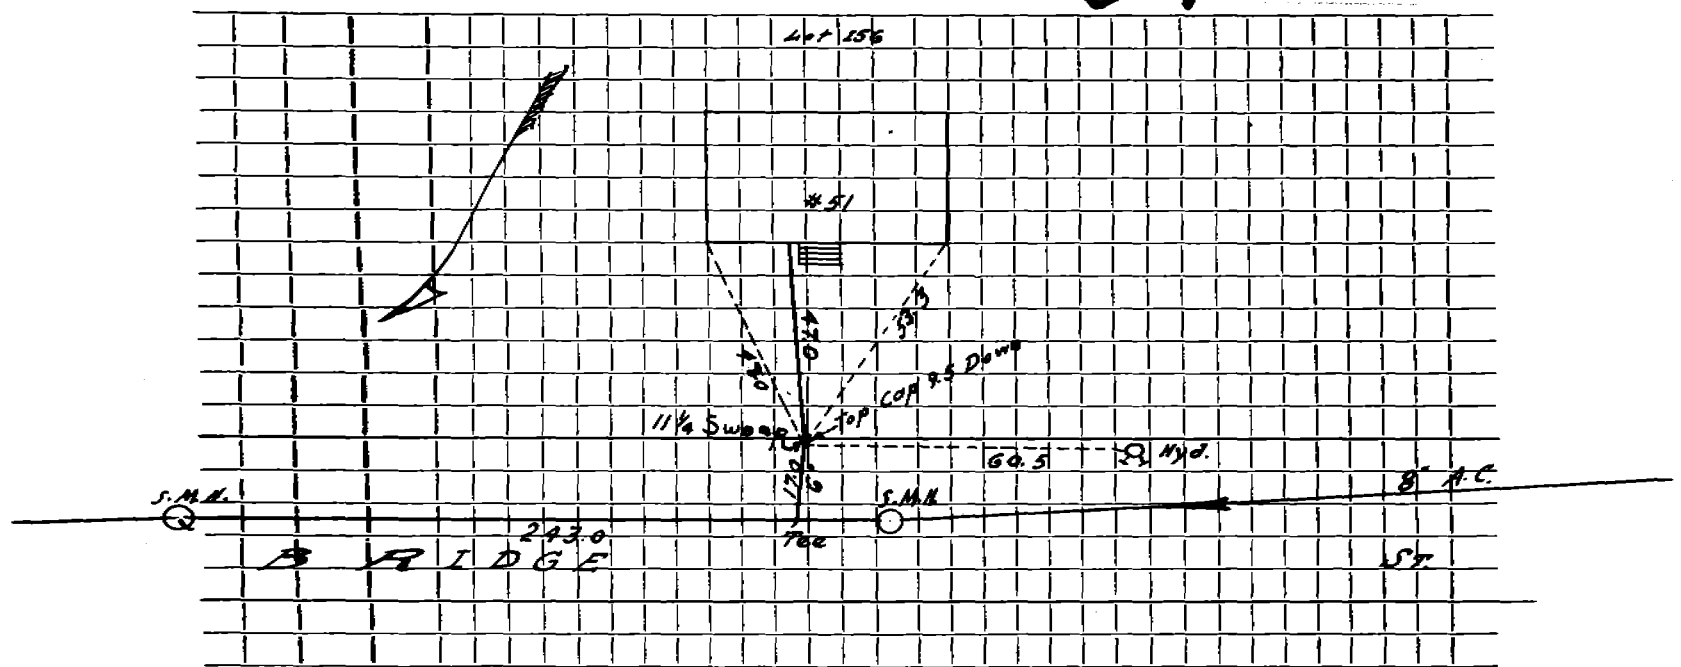

Connection made in Street. Work completed

marks:
.....
.....