

Name Zita Ricci

Service No. 65

Address 55 Bridge Street

Location

Kind of Pipe

Size

Size of Main

Repair—Renewal—New Service

Lexington Sewerage #672

Location

JUL 24 1966

Date

Material

Amount

Total

Date

Amount

~~Jul '66 24' 6" Transite pipe @5.00~~

120.00

6-14-67

Deposit

120.00

6-22-67 37' 6" Transite pipe

10' 4" Cast Iron pipe

7- - 66


24' 6" Transite

DATE _____

TOWN OF LEXINGTON — BOARD OF PUBLIC WORKS
SEWER DIVISION

Sketch of Service Here

55

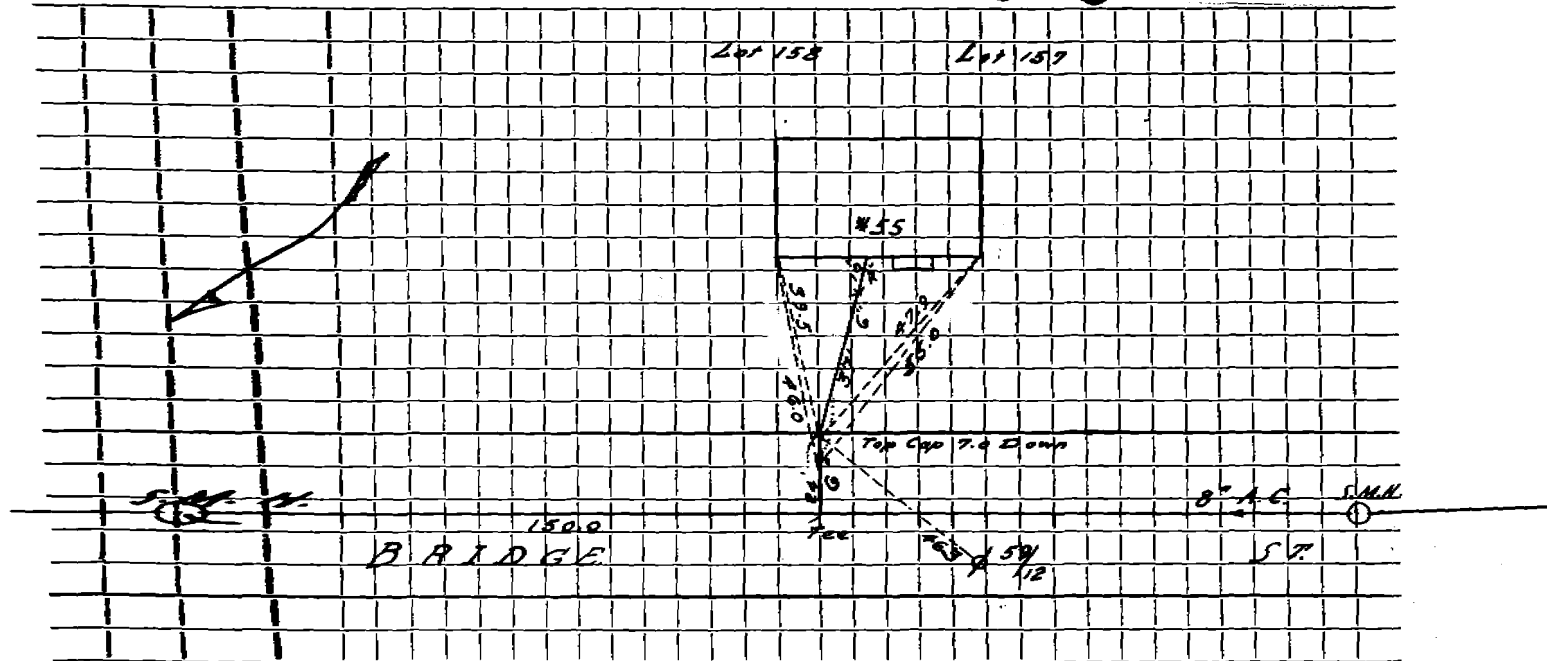

Connection made in Street. Work completed

Remarks:

.....

.....